


A
N
A

1" = 400'

T 9 S R 45 E 12 M

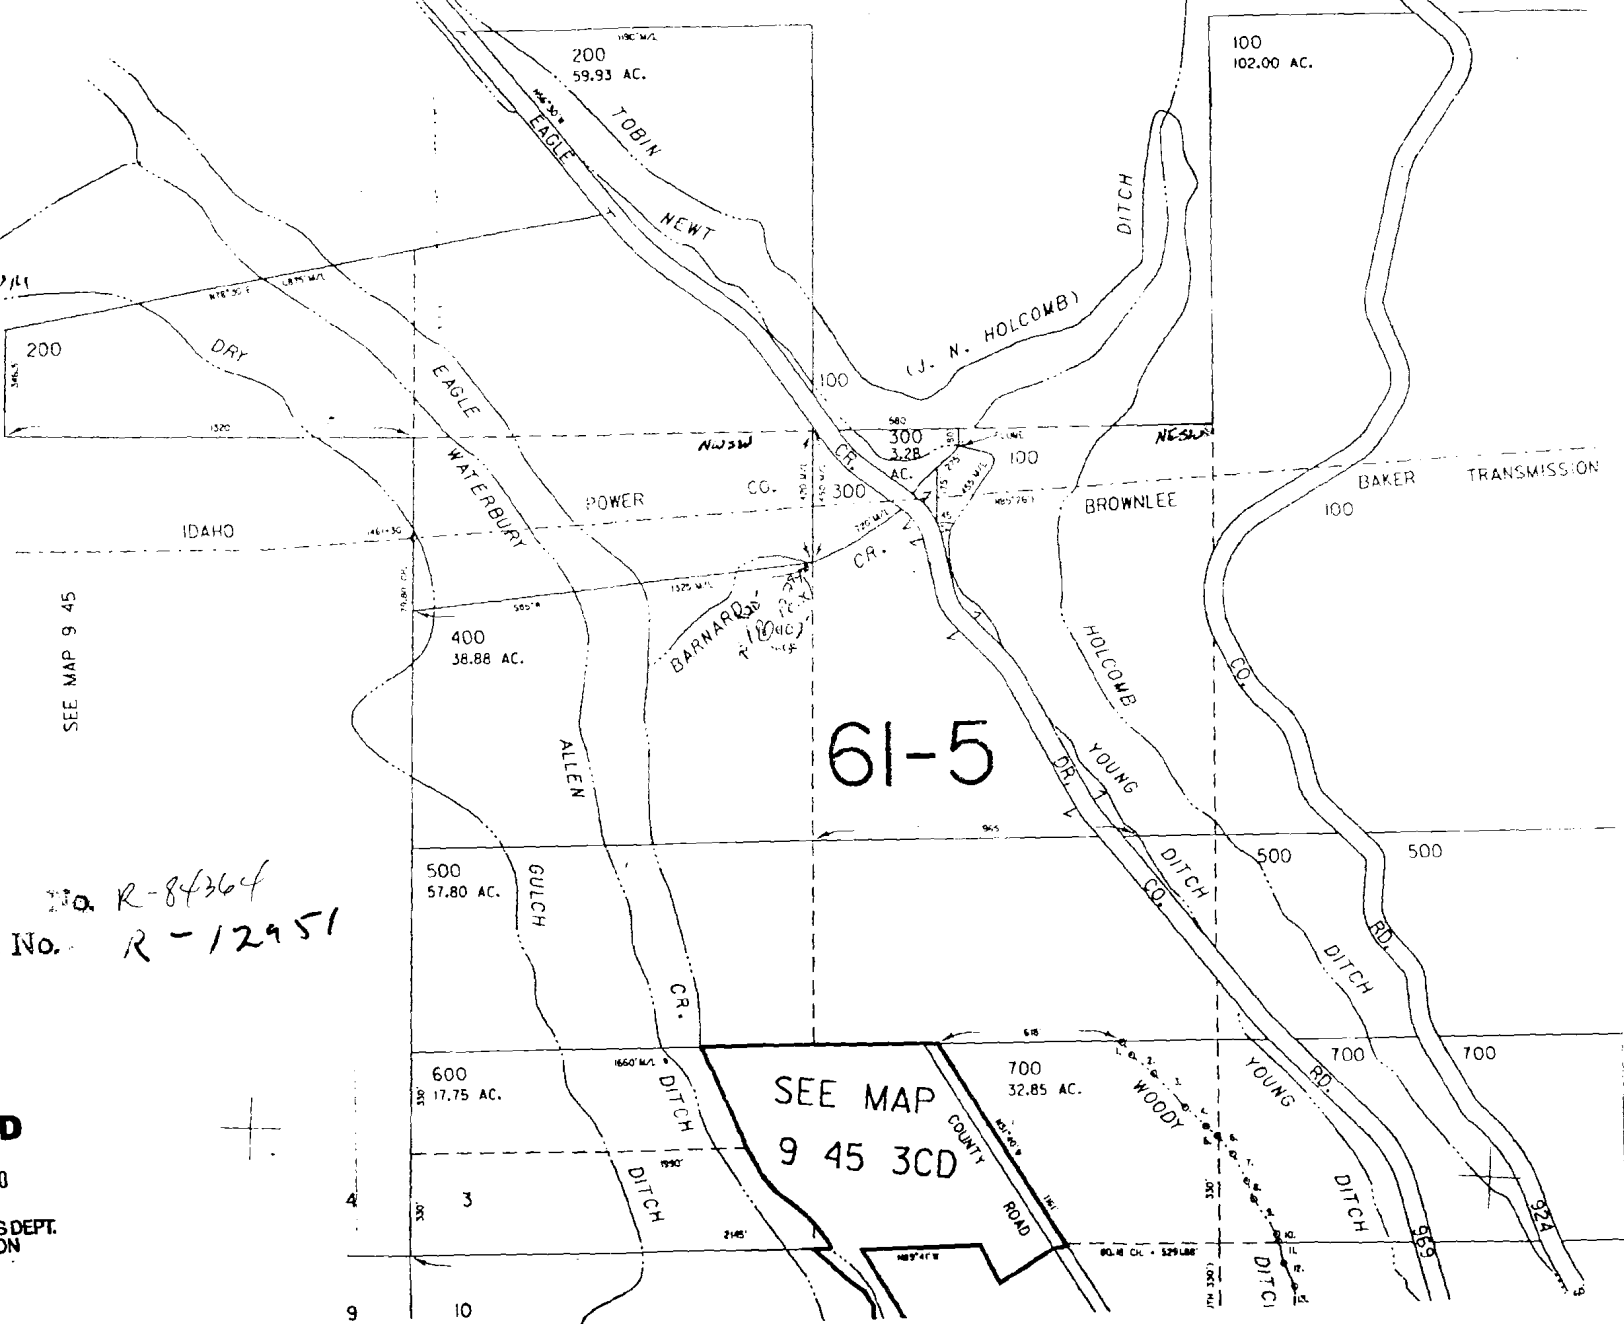

SEE MAP 9 45

61-5

Permit No. R-84364
Permit No. R-12951

SEE MAP
9 45 3CD

RECEIVED

MAR 6 2000

WATER RESOURCES DEPT.
SALEM, OREGON