


41244

T40S. R19E. WM.

RECEIVED

JUN 02 2000

WATER RESOURCES DEPT.
SALEM, OREGON

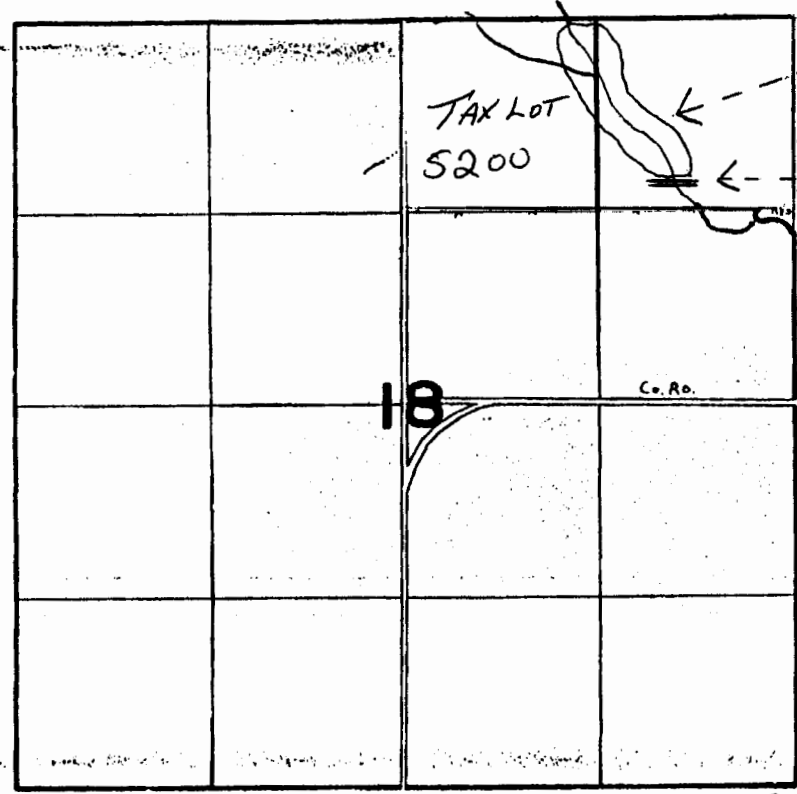

Proposed Dam Loc. 1520' N & 1900' E from C 1/4 Cor Sec 18

Application No R 84444
Permit No. R 12984