


# CONCEPT MAP

## FOR PONDS

40-9-25-10

TC 1601, 1602

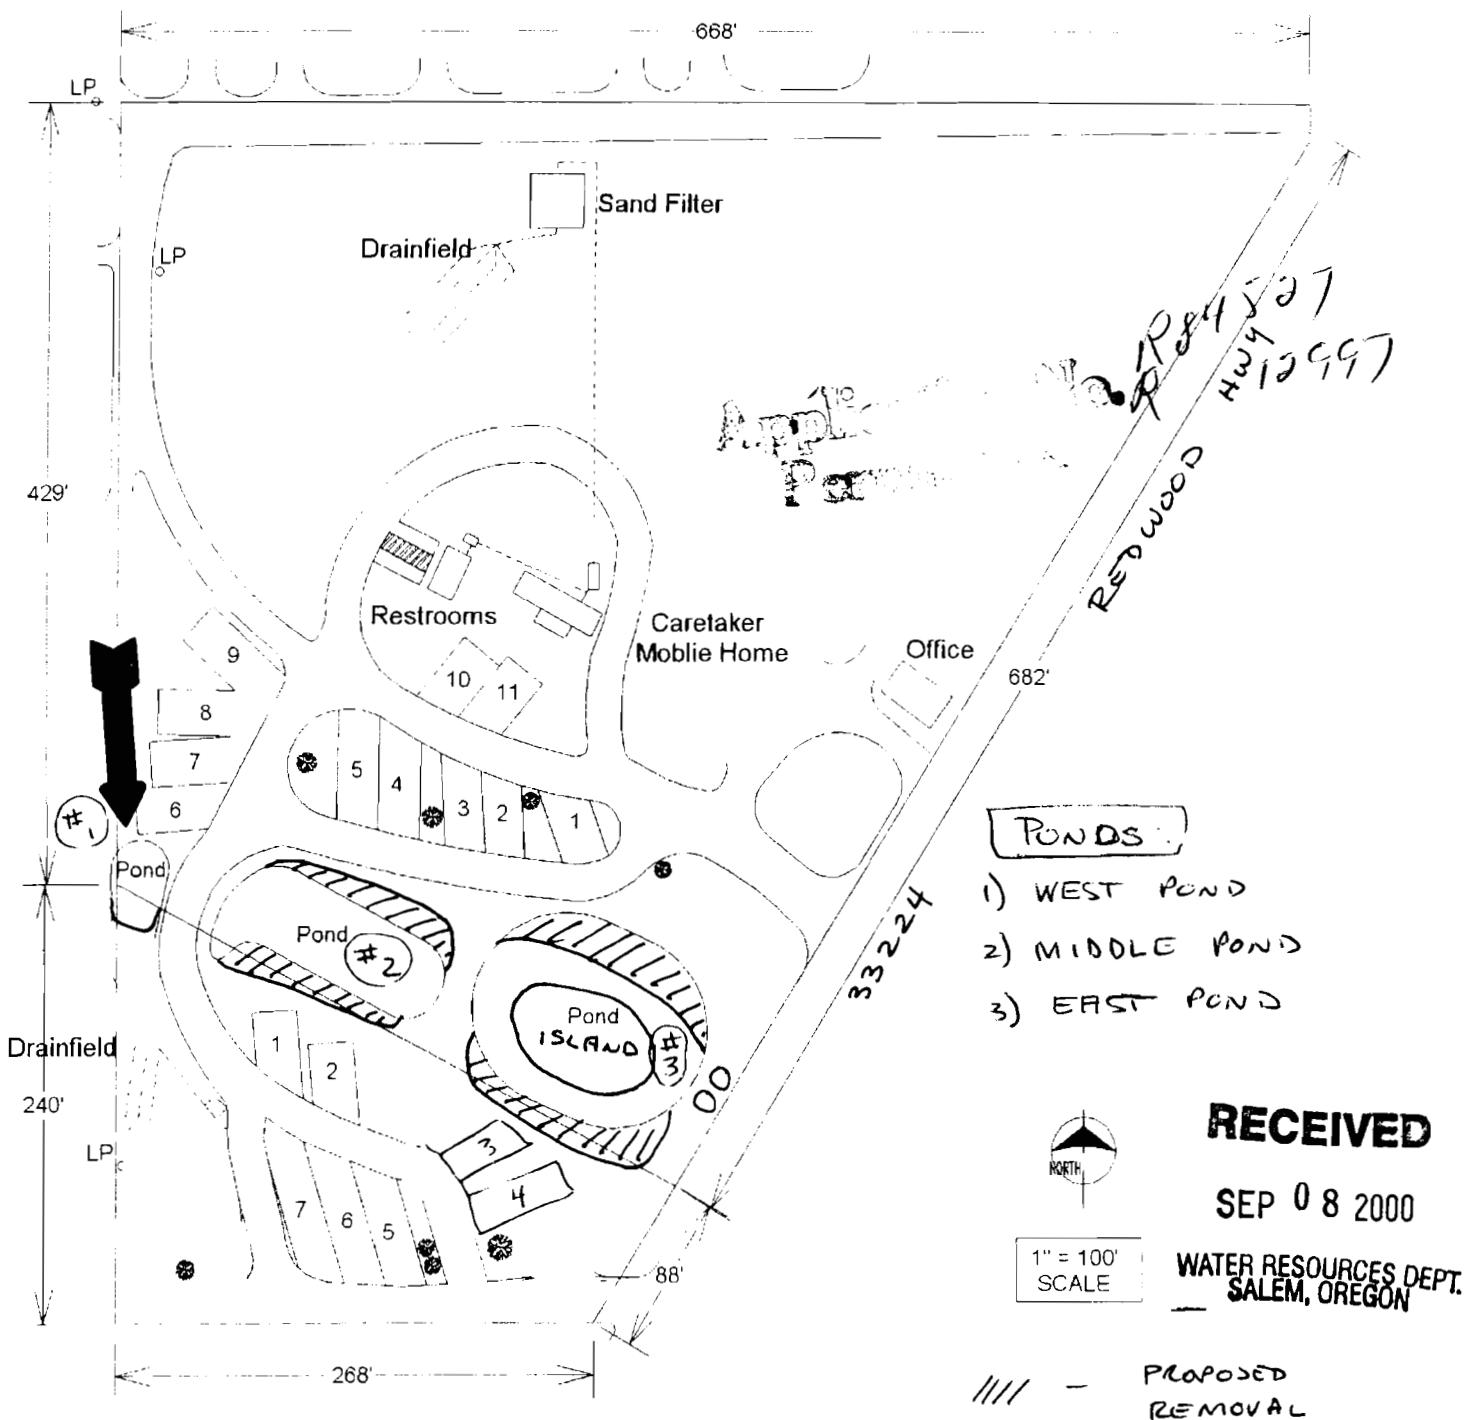

DRAFTERMAN'S COPY

IK 22


NE1/4 SEC. 25 T.40S. R.9W. W.M.  
JOSEPHINE COUNTY

40 9 25

: 200

used for  
a copy.

SEE MAP 40 9 24

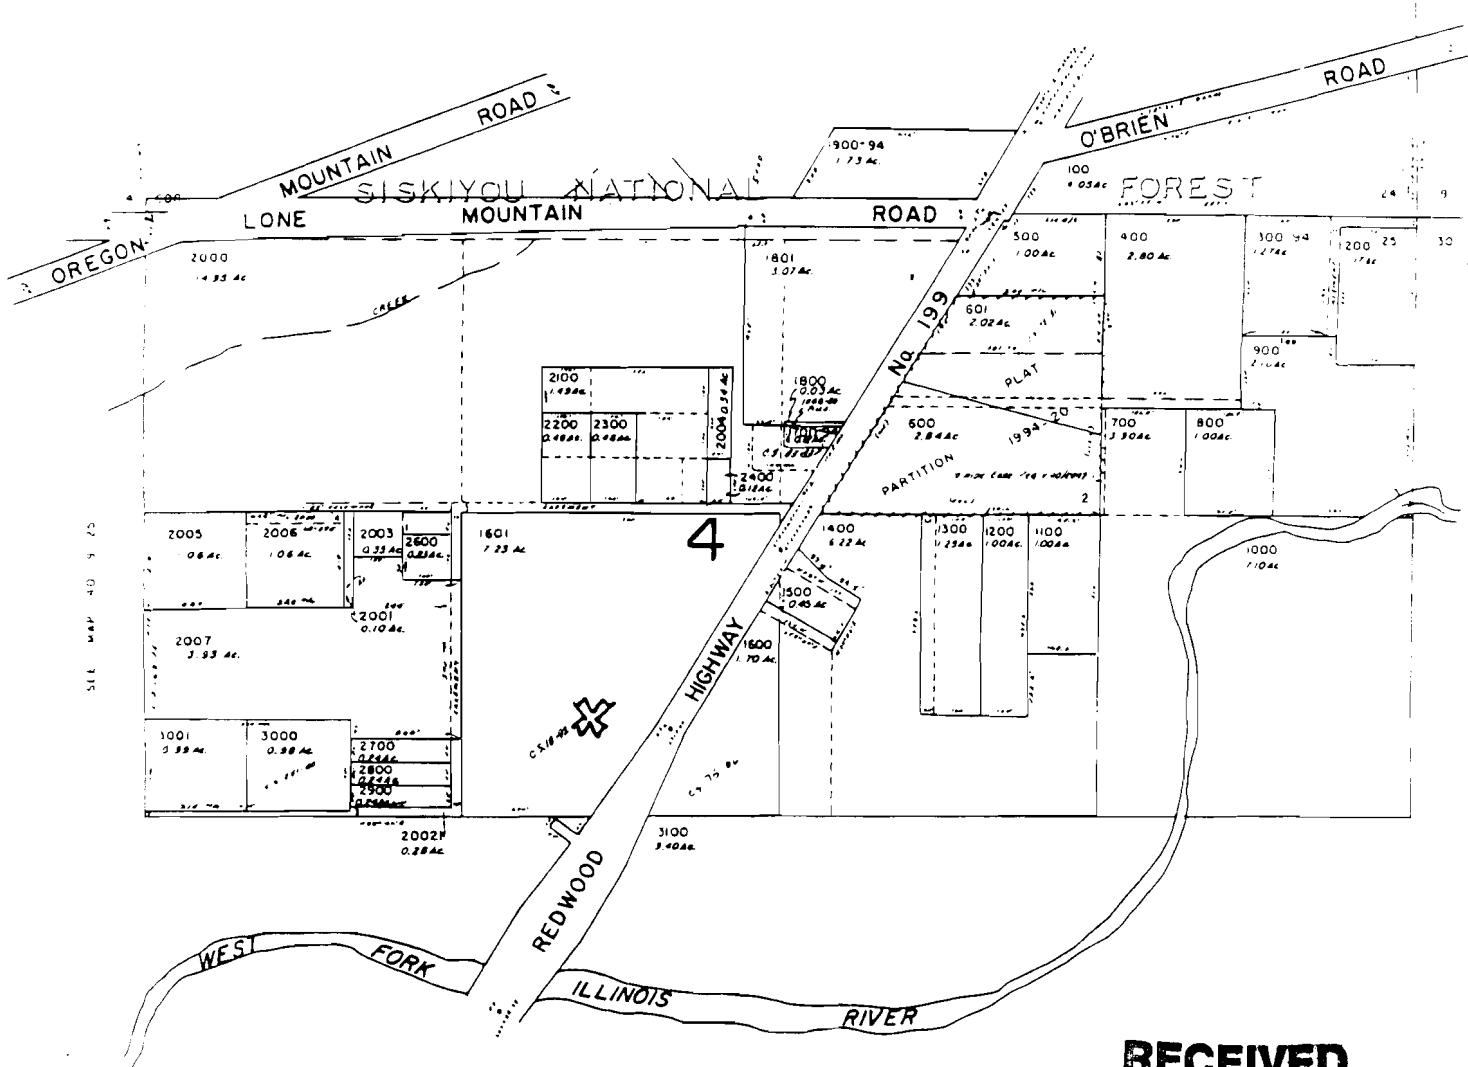

RECEIVED

SEP 08 2000

WATER RESOURCES DEPT.  
SALEM, OREGON

Approved by R 54527  
Permit No. R 12997

40 9 25

40-9-25-10