

THIS MAP WAS PREPARED FOR
ASSESSMENT PURPOSE ONLY

SECTION 16 T4S R5W W.M.
YAMHILL COUNTY

1" = 400'

4 5 16
FILE COPY

CANCELLED
800

SEE MAP 4 5 09

9 10
16 15

RECEIVED


JUL 0 5 2000

WATER RESOURCES DEPT.
SALEM, OREGON

Application No. 84484
Permit No.

SEE MAP 4 5 17

SEE MAP 4 5 15

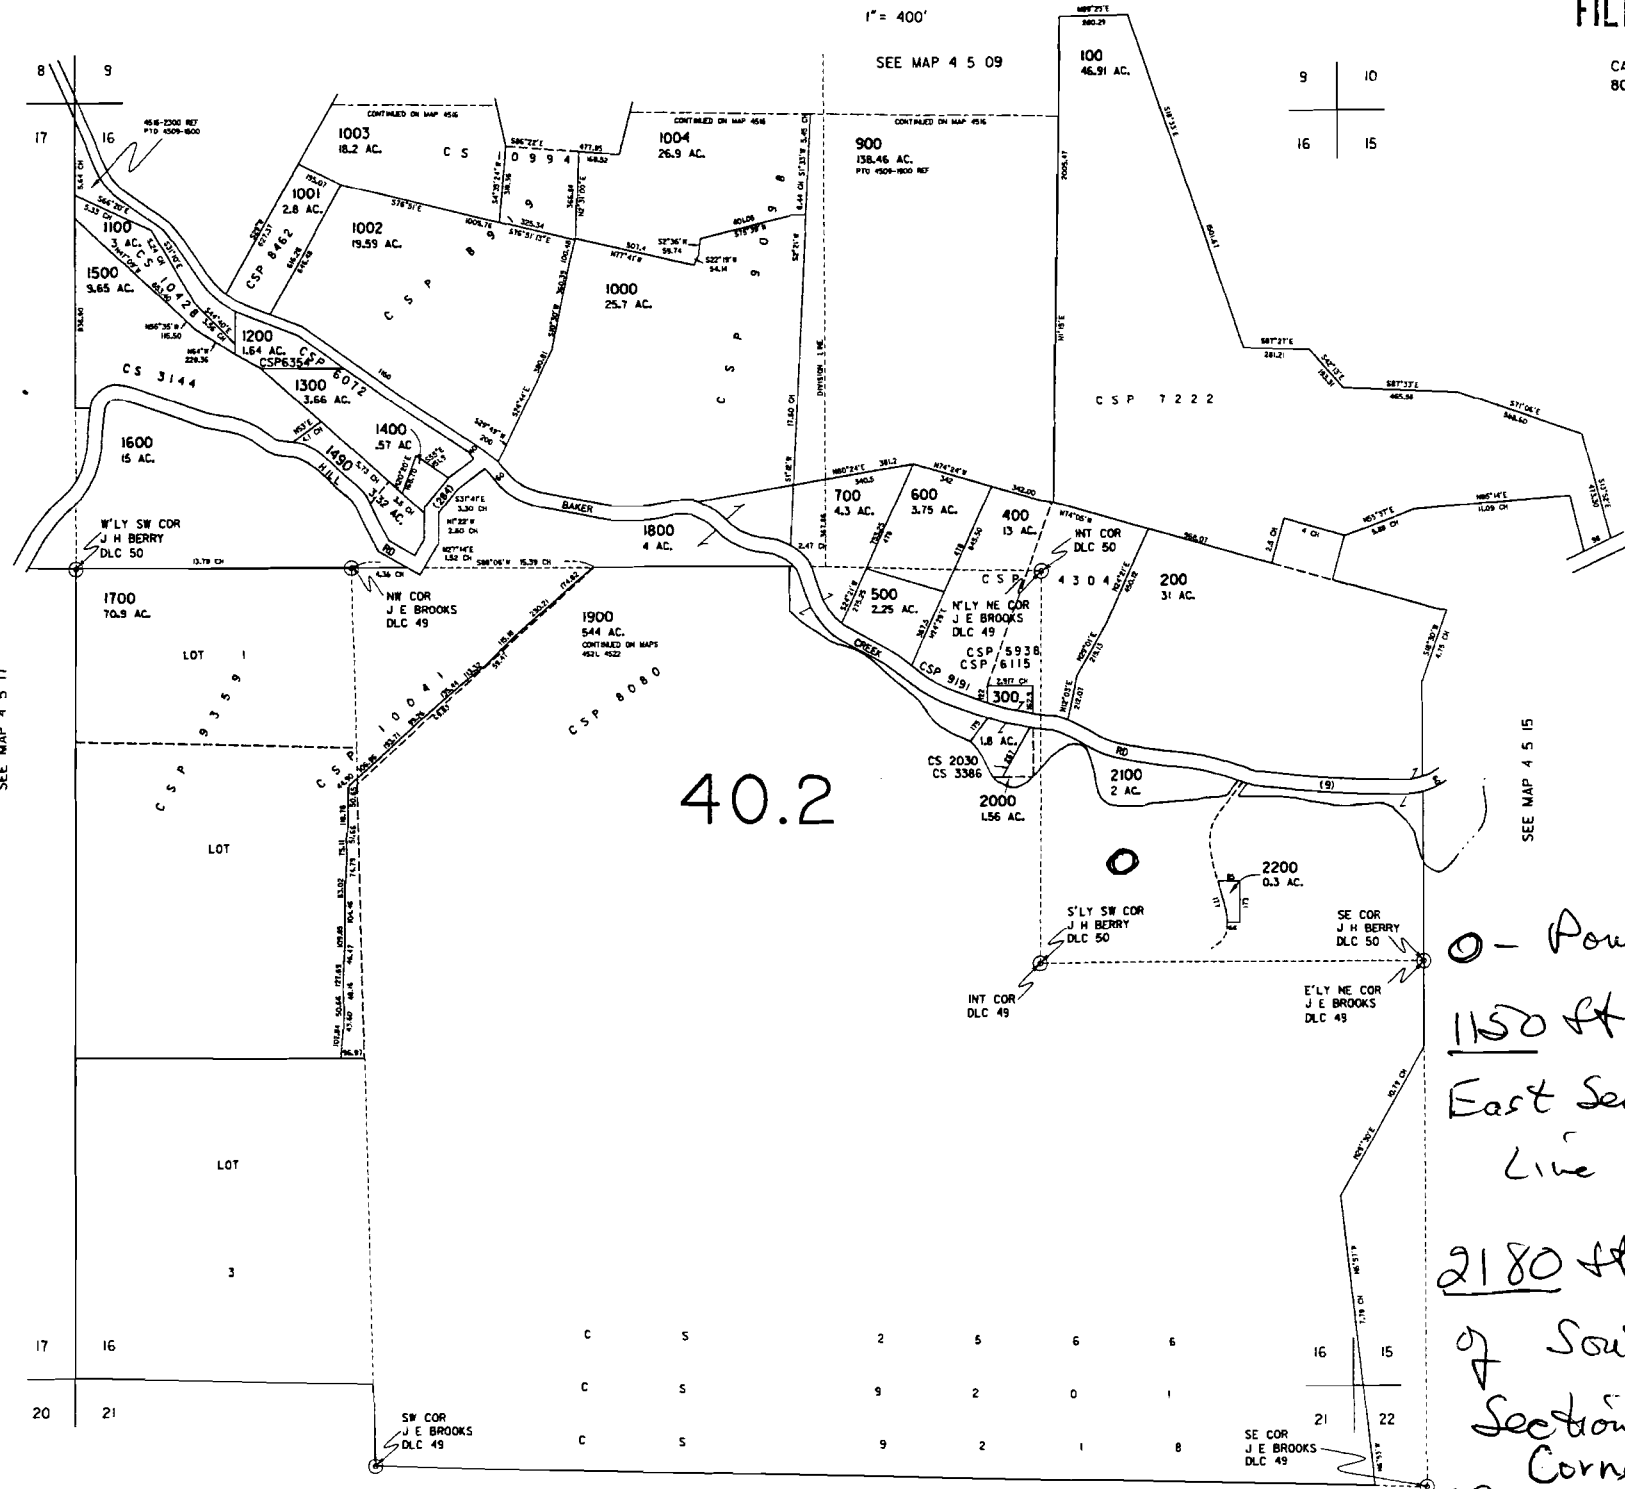

○ - Pond
1150 ft W. of
East Section
Line
2180 ft N.
of South East
Section ~~the~~
Corner

8-12-00 4 5 16