


SEE

149.31 Ac.

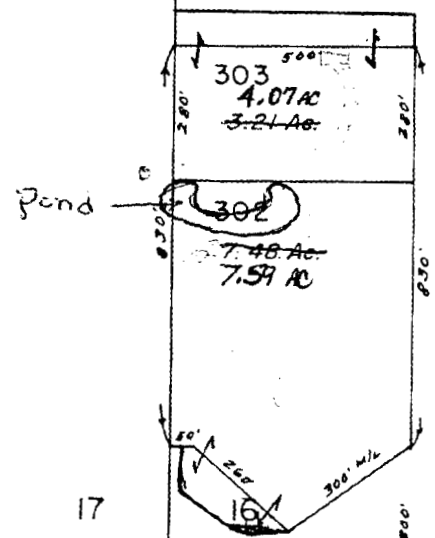

C. S. 113-60

501  
40.03 Ac.

500  
8.34 Ac.

590  
0.82 Ac

503  
6.6

LIMPY CREEK

20

21

SEE MAP 36 7 21

365-7w-16

Application No. 84502  
Permit No.

Scale = 1" = 400'

RECEIVED

AUG 07 2000

WATER RESOURCES DEPT.  
SALEM, OREGON

