


Application No. R 84517
 Permit No.

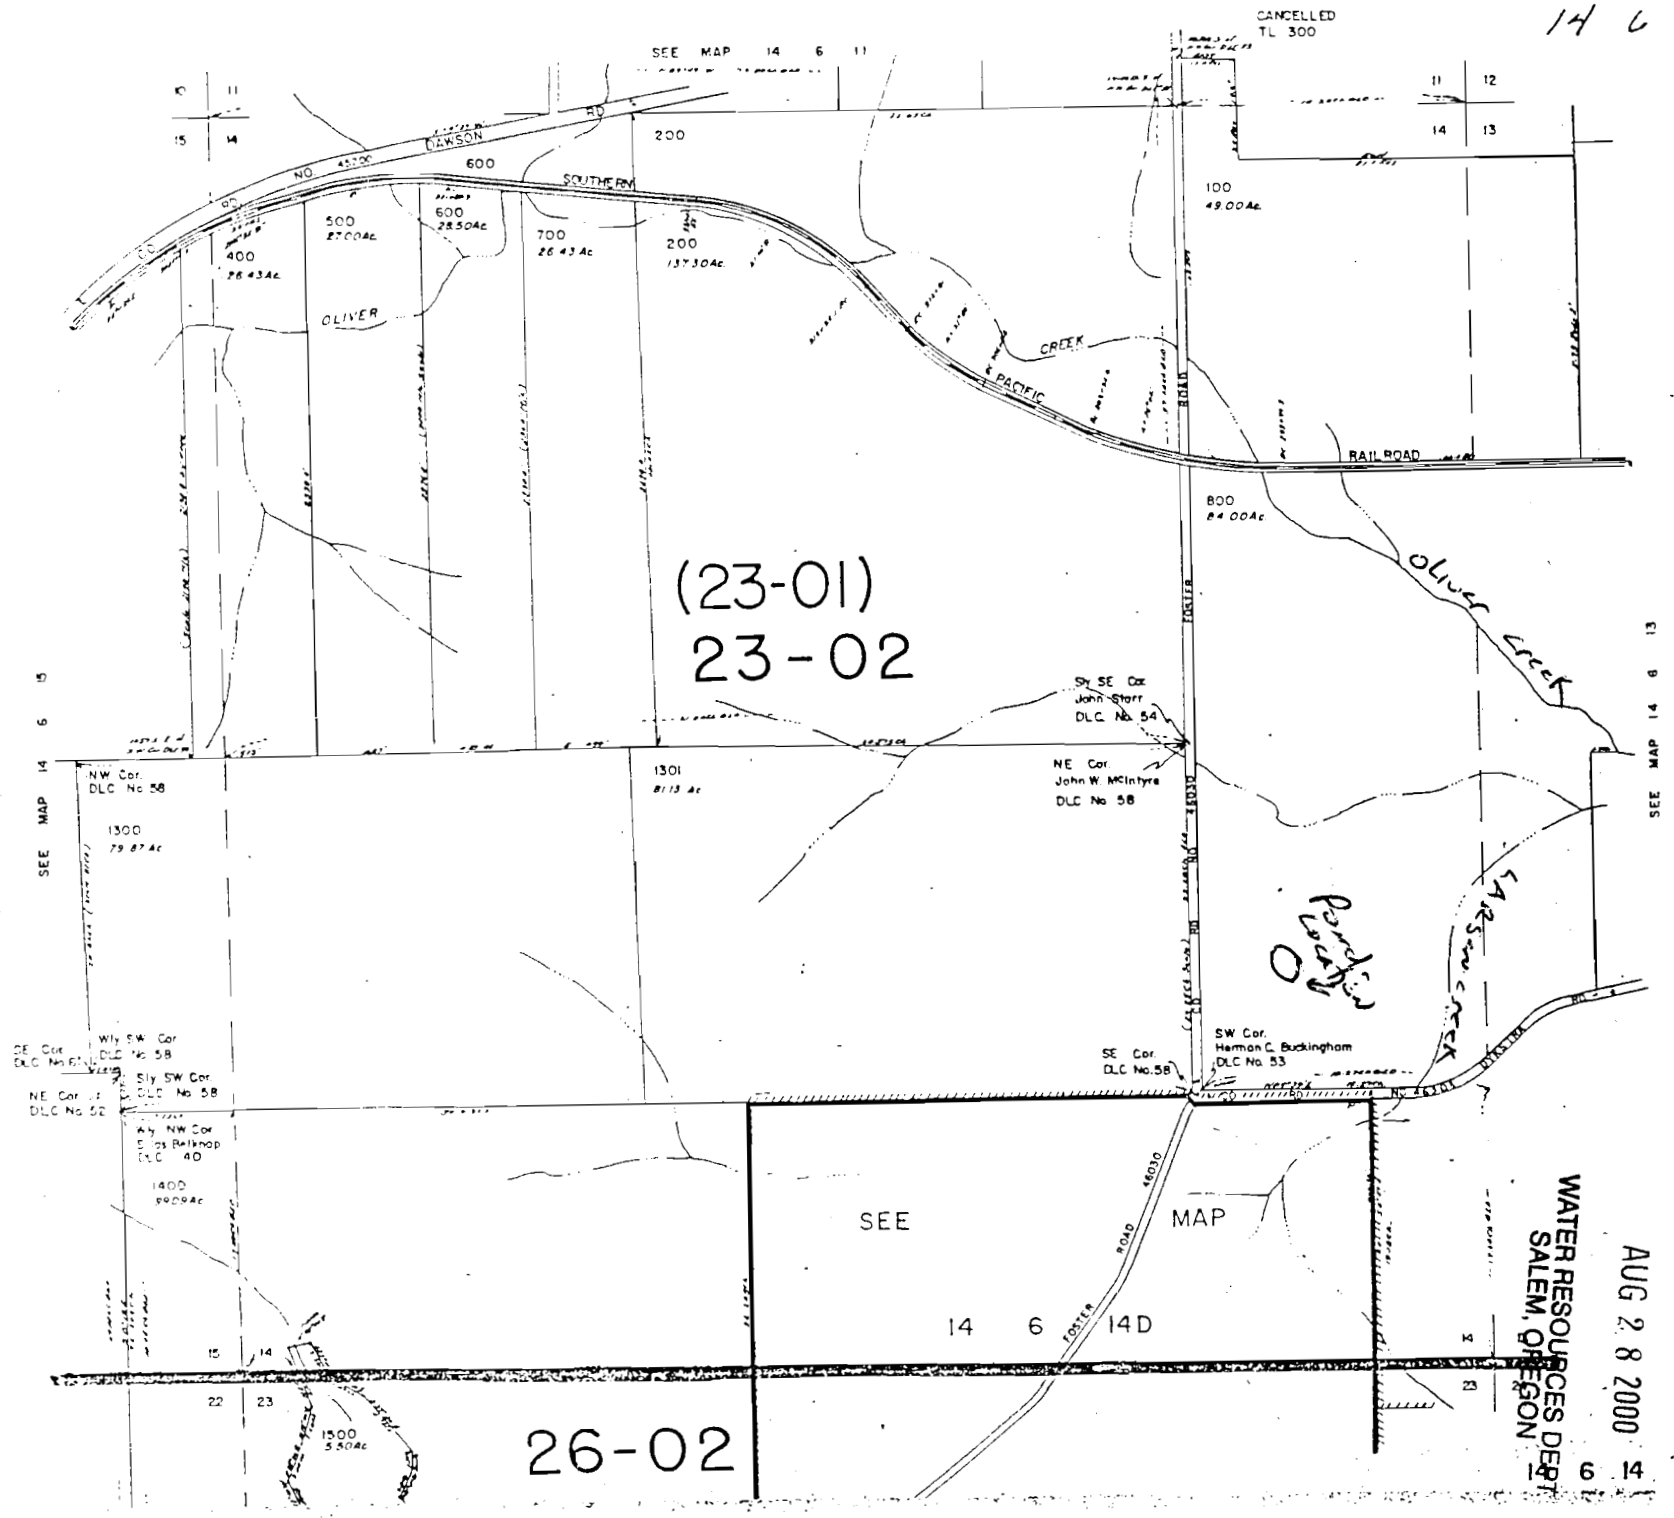

(23-01)
23-02

26-02

SEE MAP

14 6 14D

WATER RESOURCES DEPT
SALEM, OREGON

AUG 28 2000

RECEIVED

14 6 14

SEE MAP 14 6 13

CANCELLED
TL 300