


02 08 01 13:51 500 378 0203

WATER RIGHTS NO.

2002

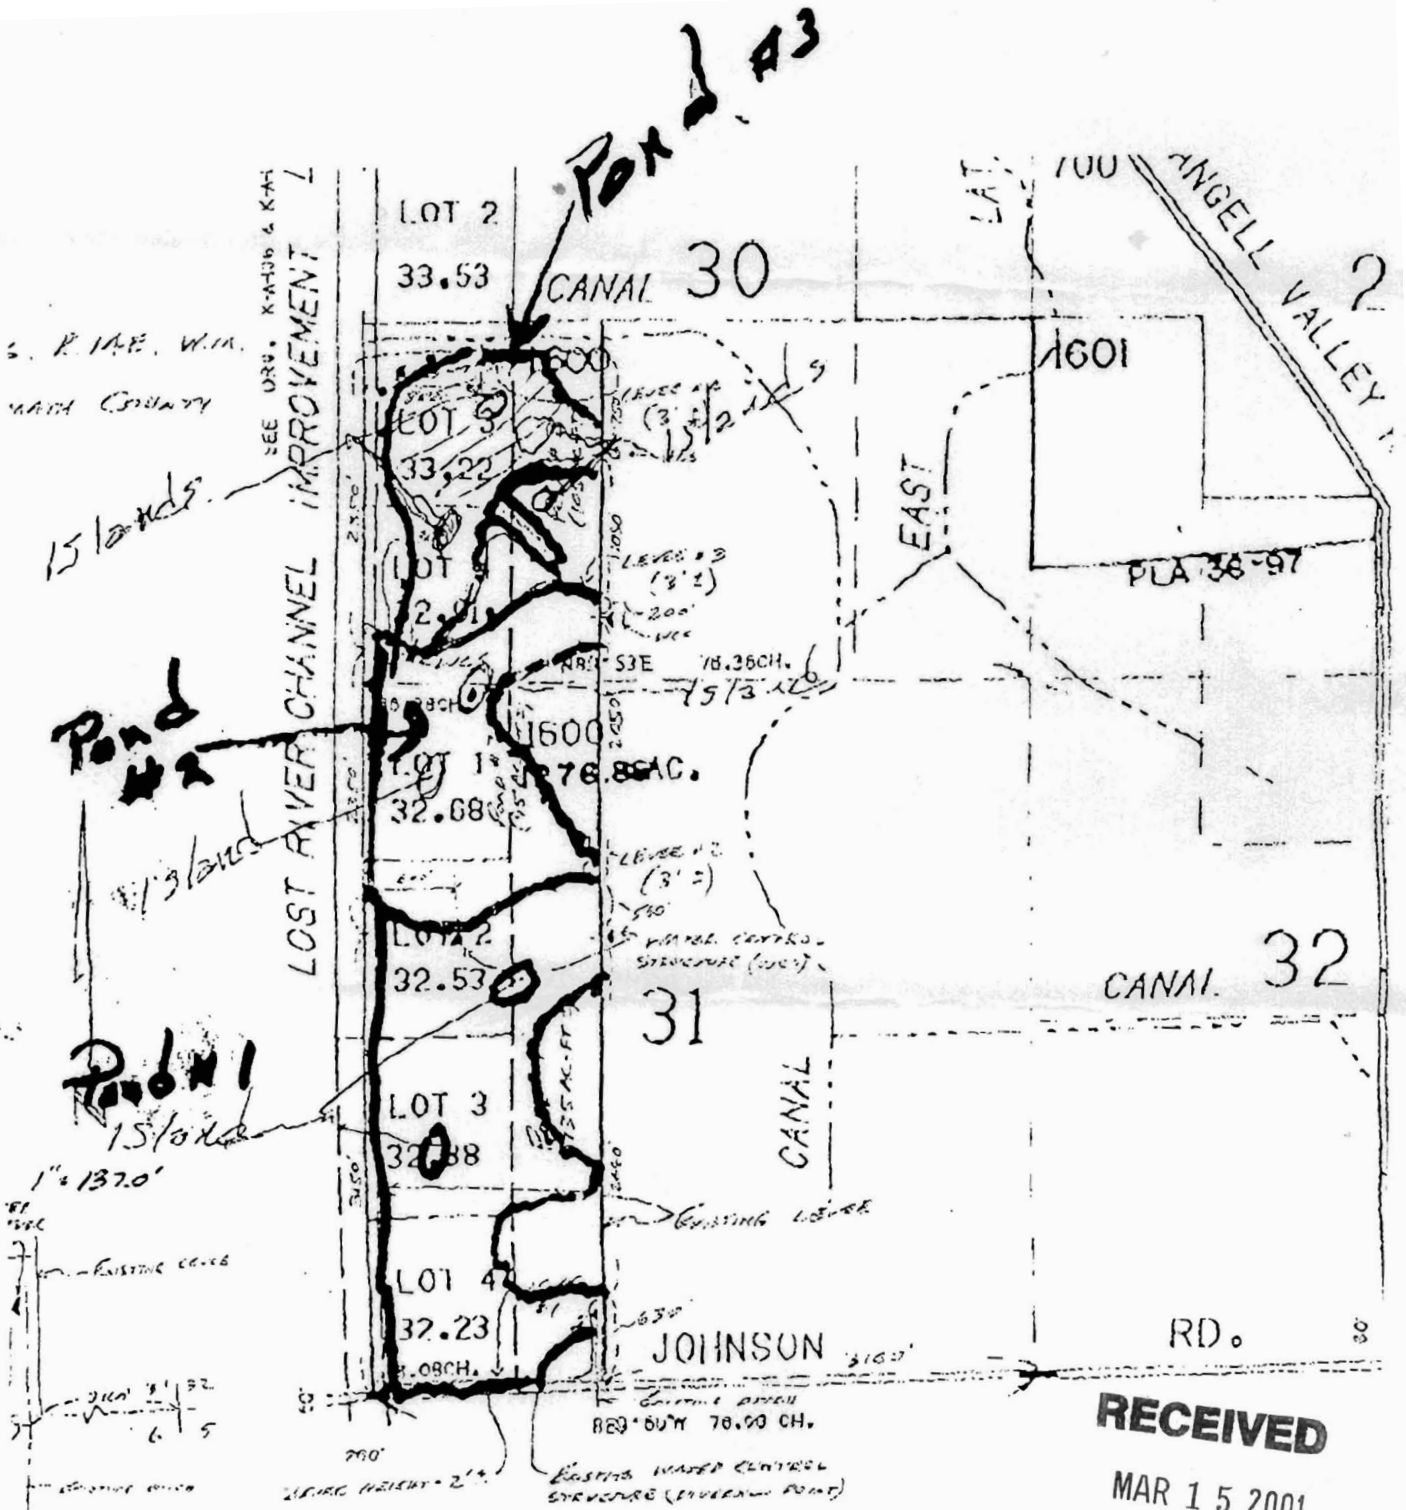

RECEIVED

MAR 15 2001

WATER RESOURCES DEPT.
SALEM, OREGON