


1701 1800  
 304 305  
 2700 302  
 303 302  
 3600 1411 2700-2200  
 2702 1504  
 2405 2504  
 503 401  
 1000 1100  
 308 307  
 2505 2406

N.E. 1/4 SEC. 27 TWP. 38S. R.3W. W.M.

38 3W 27A

SCALE, 1" = 200'

38 3W 22

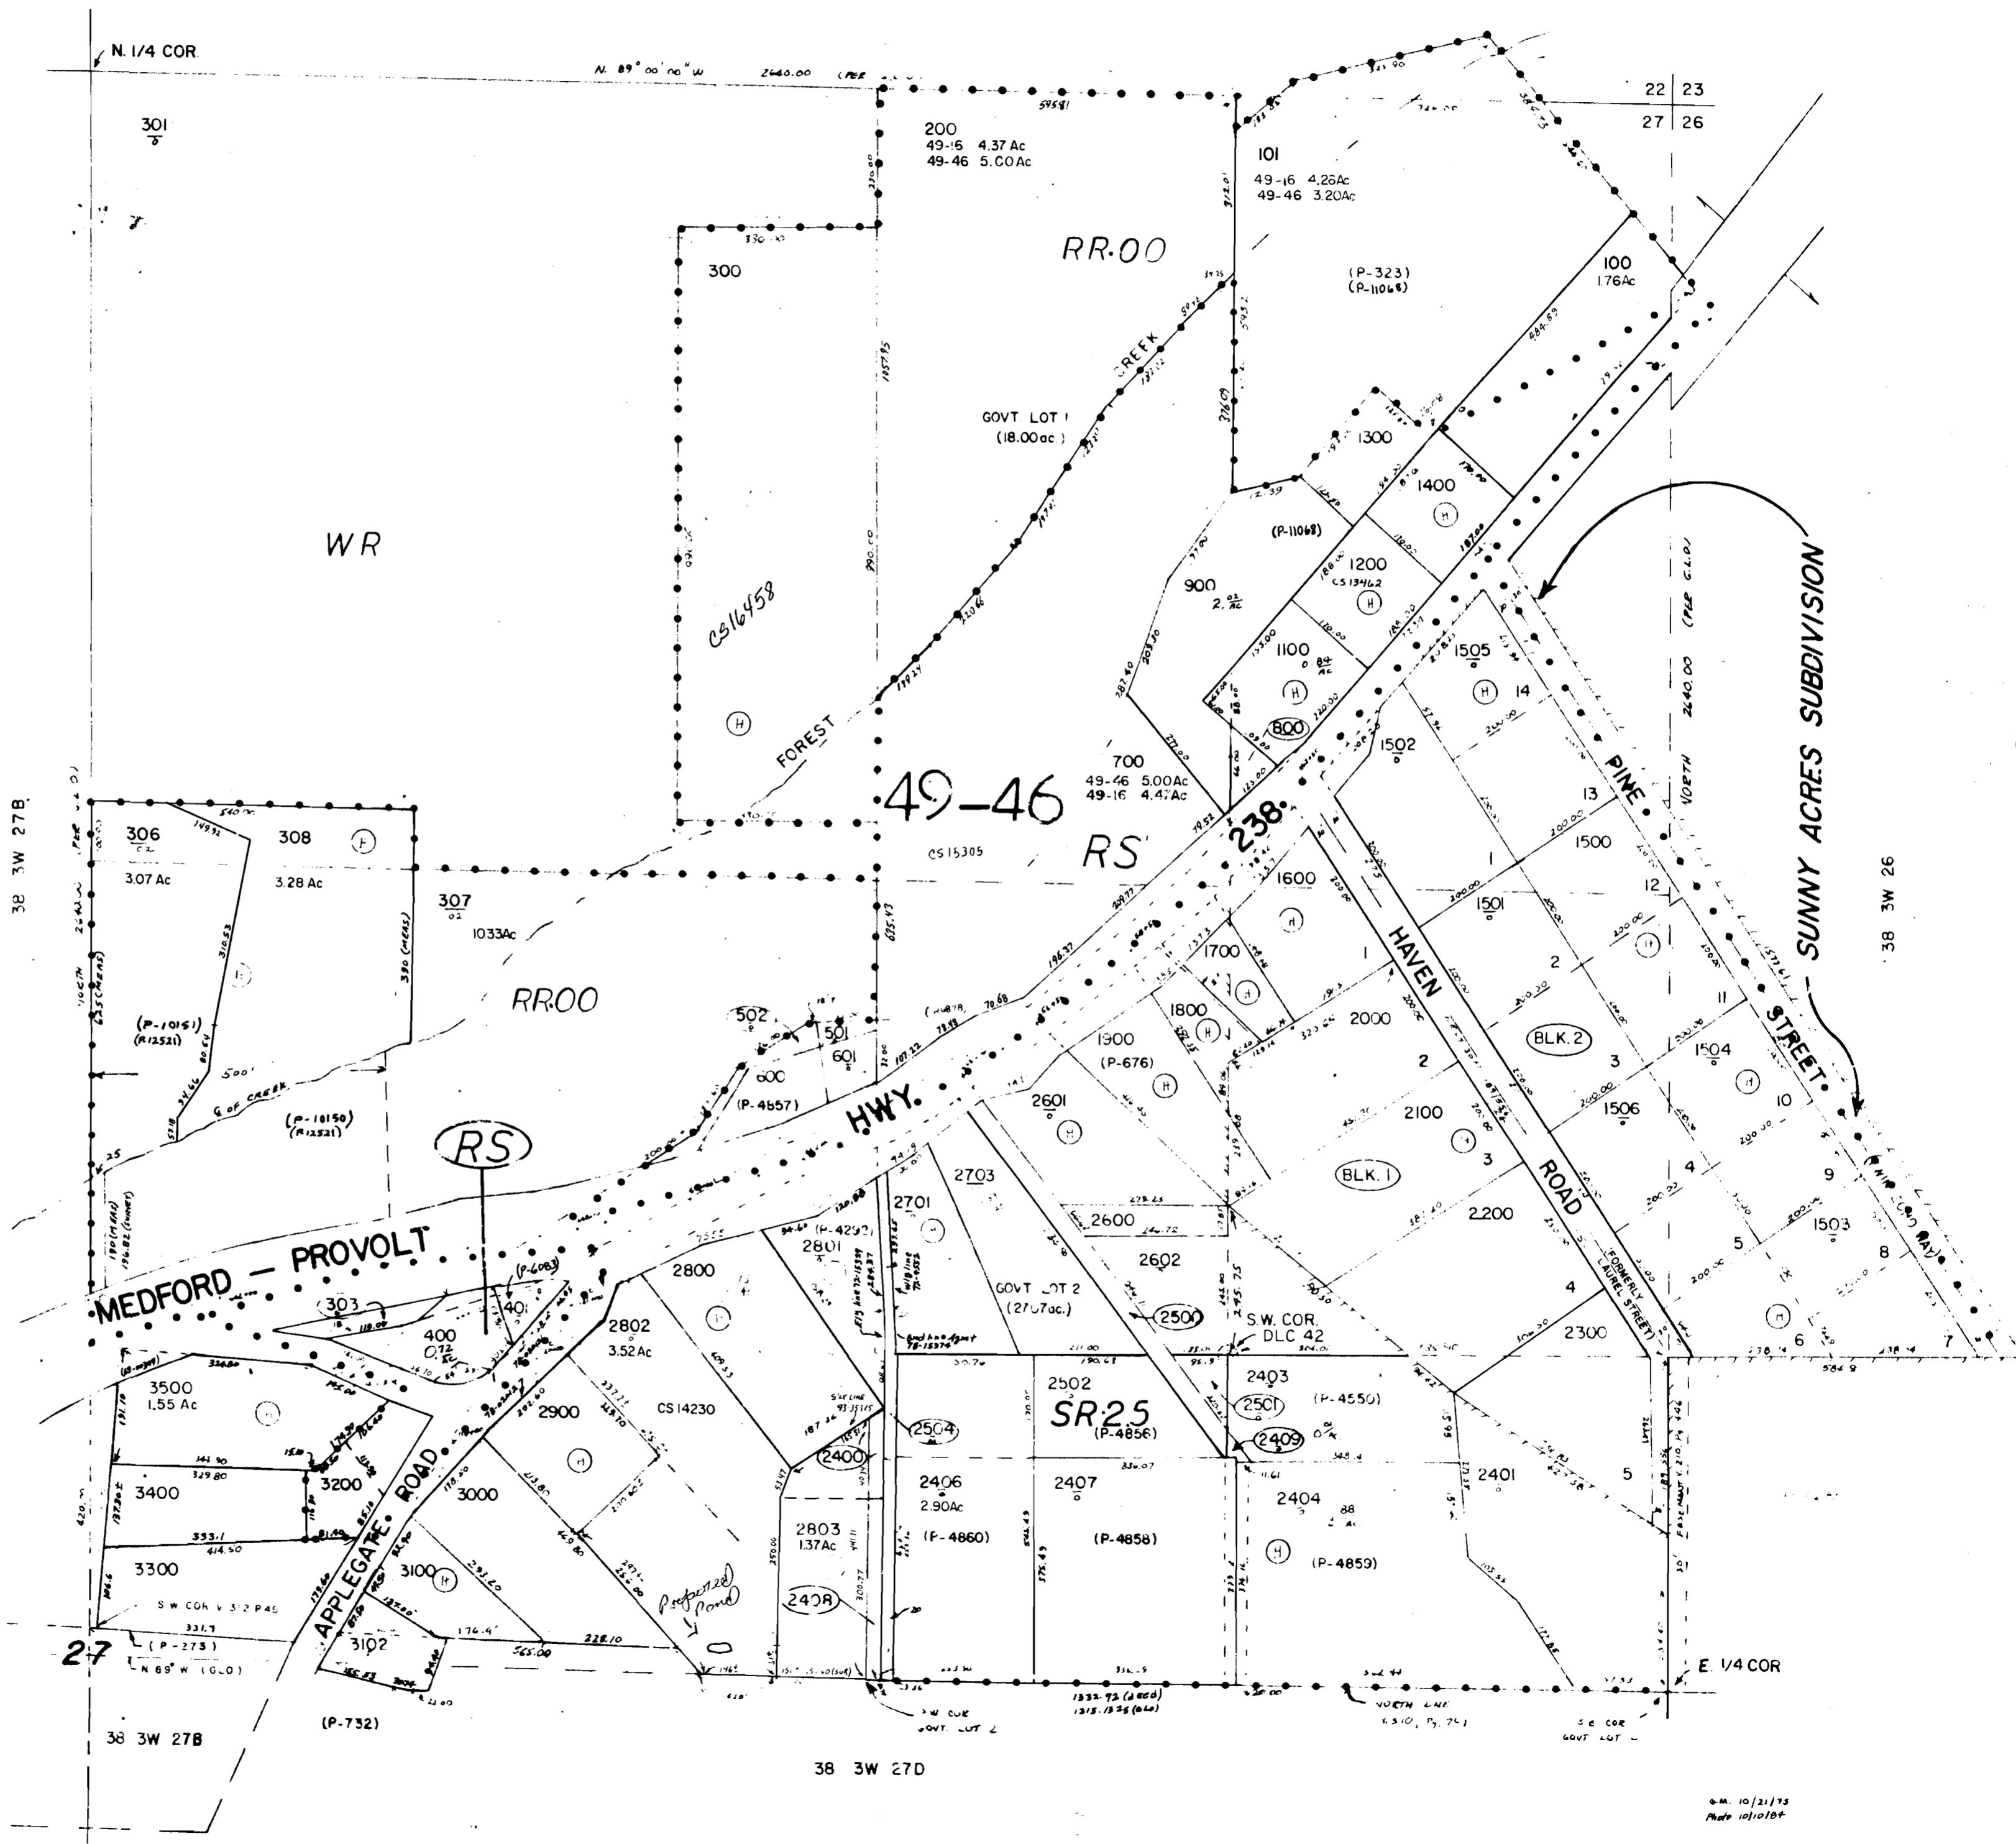

RECEIVED

OCT 24 2000

WATER RESOURCES DEPT.  
 SALEM, OREGON

6-M. 10/21/75  
 Map 10/10/84