

POLK COUNTY

SCALE 1"=400'

SEE MAP NO. 8 5 7


85-218

SEE MAP NO 8 6 13

SEE MAP NO. 118 5 17

App # R-84663

Permit # R-13142

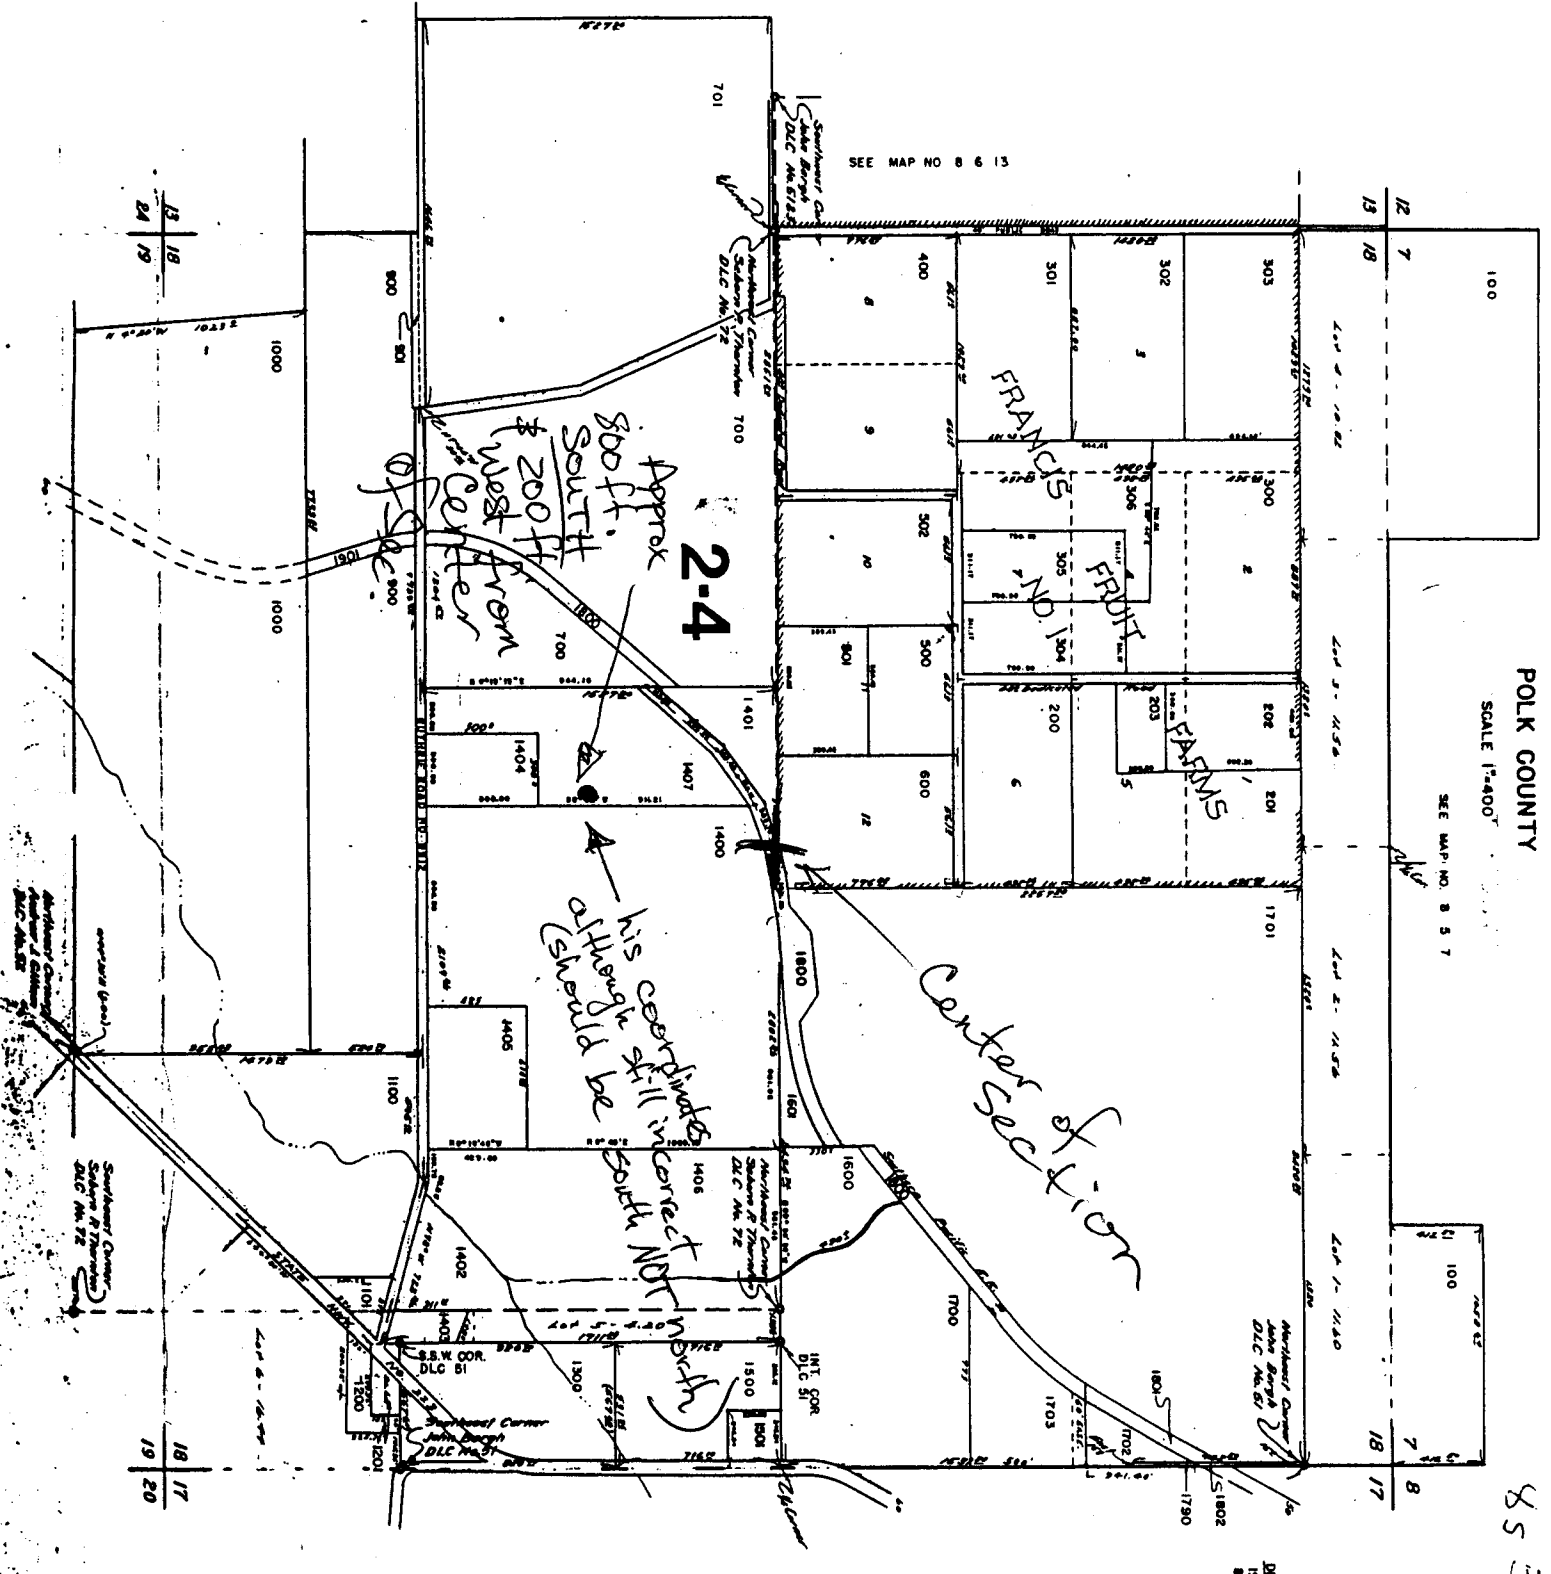

18 19
19 18

18 17
19 20

8 18

DEAD END
1500
800