

RECEIVED

OCT 22 2001


WATER RESOURCES DEPT.
SALEM, OREGON

Cancelled
T.L. 201
1300

18600

19000

1" = 400'

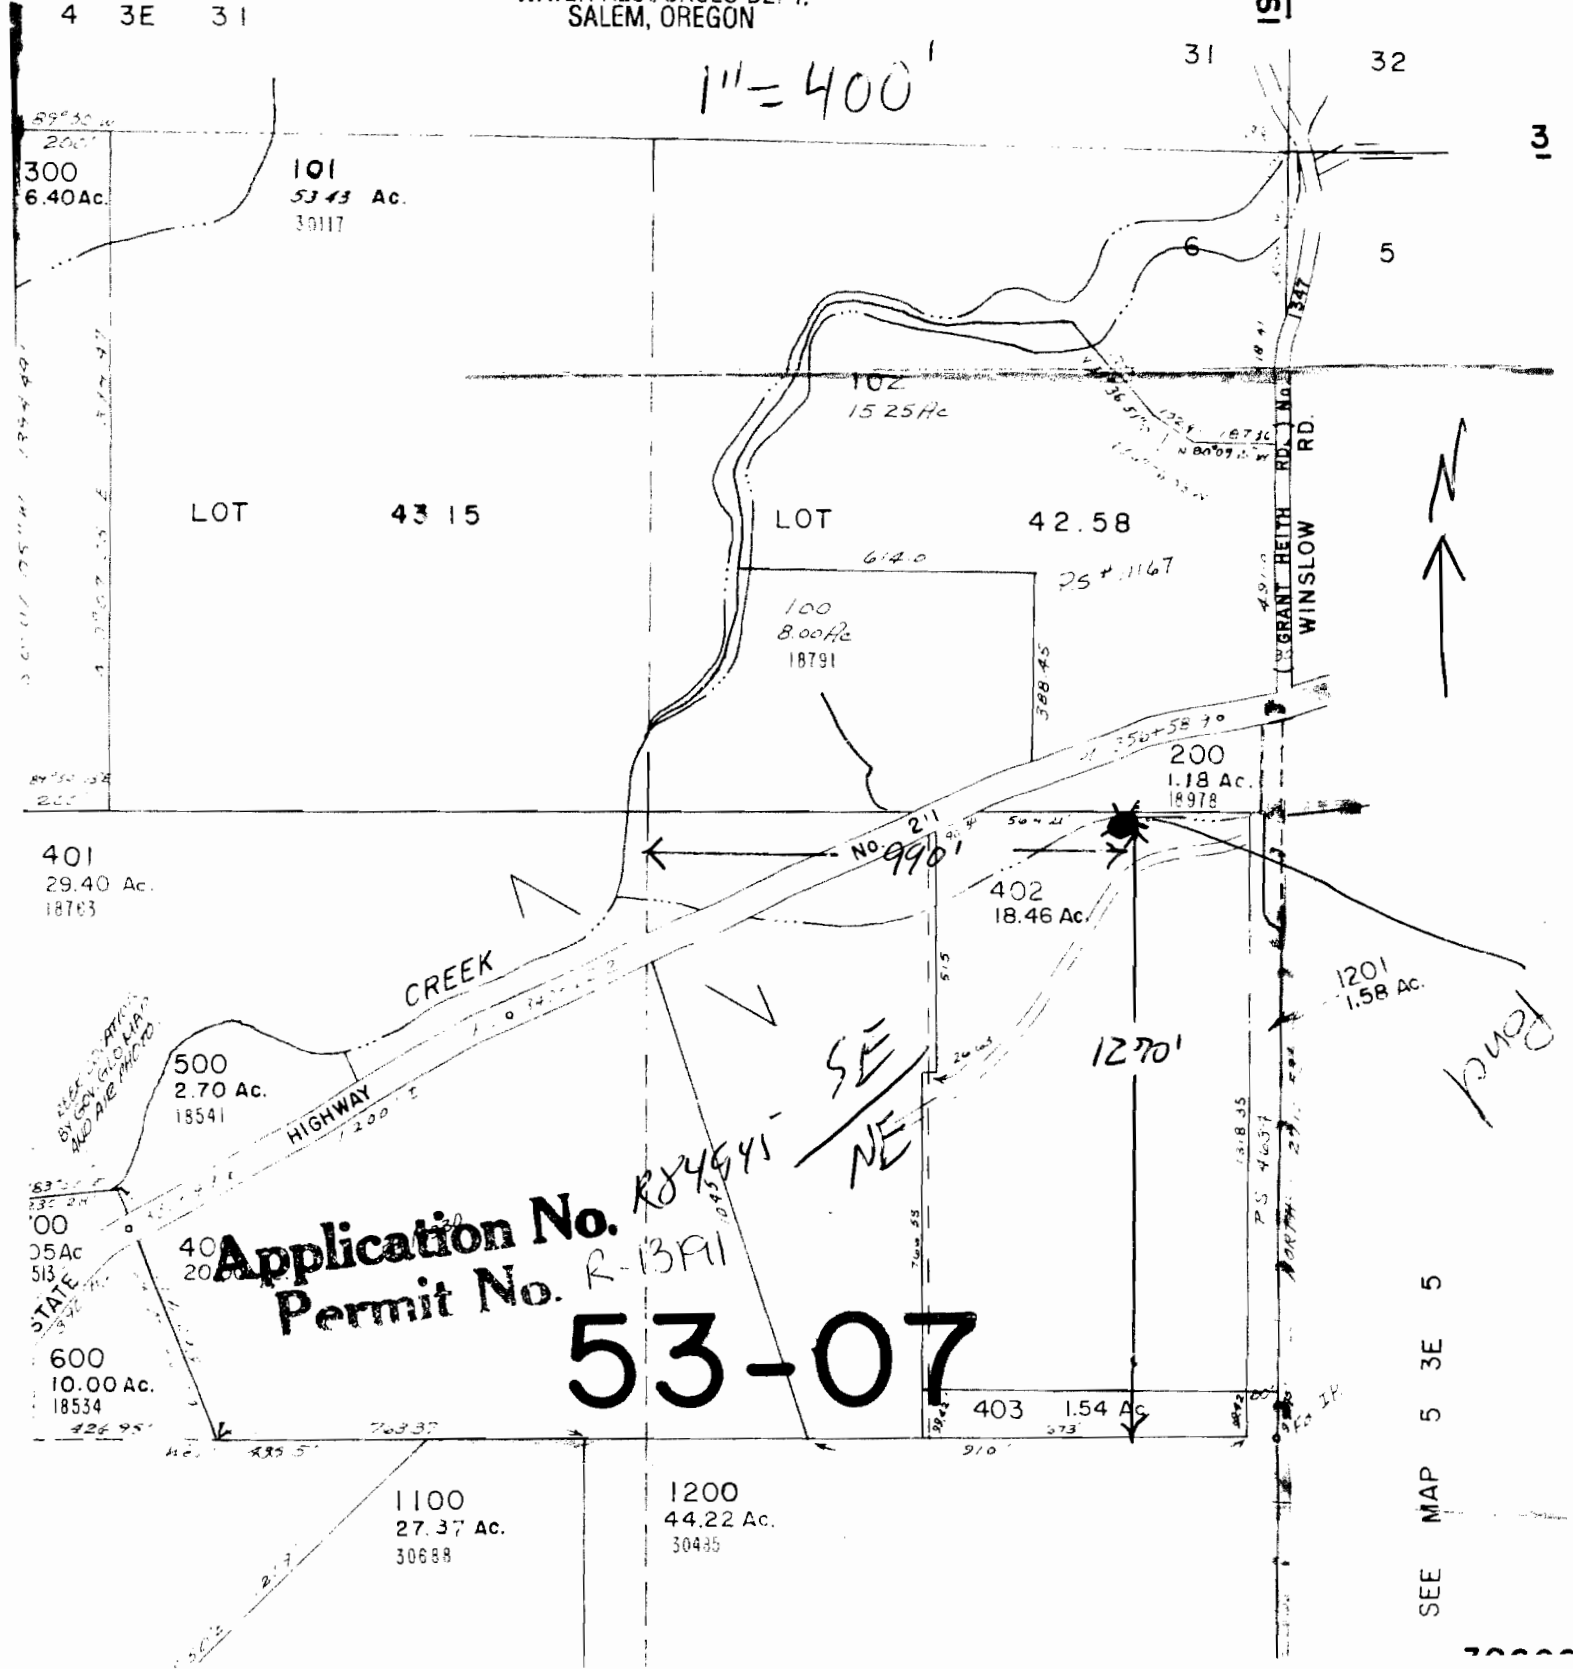


53-07

SEE MAP 5 3E 5