




Ronald L. Marx

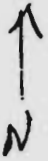

T6S R5W

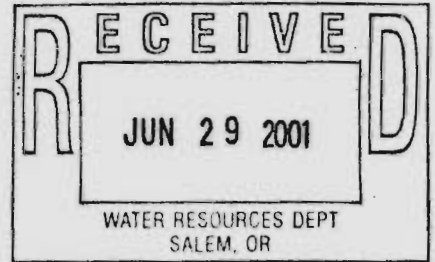

1" = 1320'

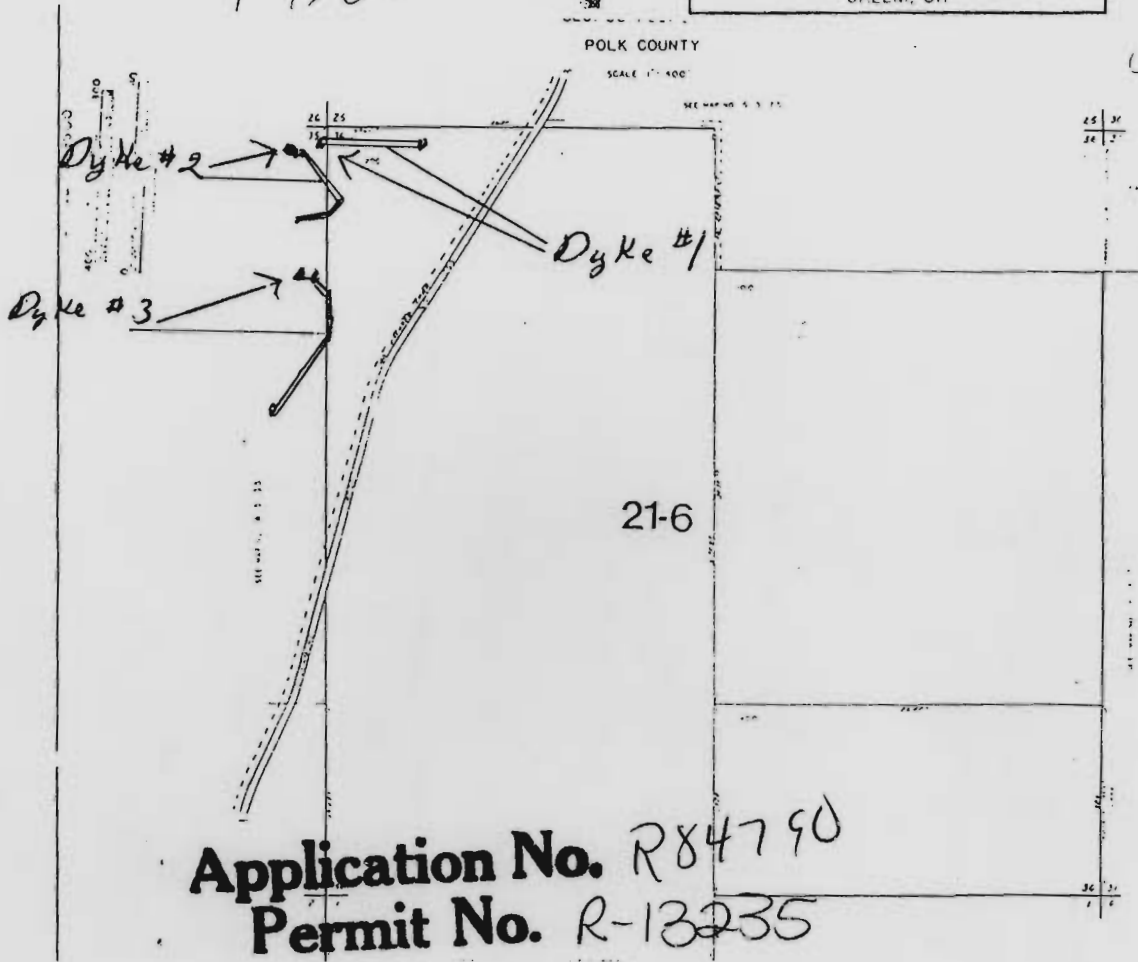

Dyke #1 Located 80'S & 75' W from NW corner Sect 36

Dyke #2 Located 80'S & 300' W from NW corner Sect 36

Dyke #3 Located 1050'S & 155' W from NW corner Sect. 36