

Township 105  
Scale 1" = 800'  
Range 4W  
Section 15

21 22

16 15

SEE MAP 10 4 16

SE COR  
JAMES GIMLES  
D.L.C. NO. 24

700  
129 424

LOT 4  
8 50

LOT 3  
17 80

LOT 2  
17 80

LOT 1  
8 82

SW COR  
SAILEY CARTER  
D.L.C. NO. 50

LOT 5  
20 91

NE COR  
TOBERT CARTER  
D.L.C. NO. 45

8-05

500  
500 A-1

500  
700 A-1

LOT 7  
15 00

500  
49 204

LOT 8  
10 00

LOT 9  
35 80

LOT 10  
10 00

LOT 11  
33 644

LOT 12  
10 00

LOT 13  
33 644

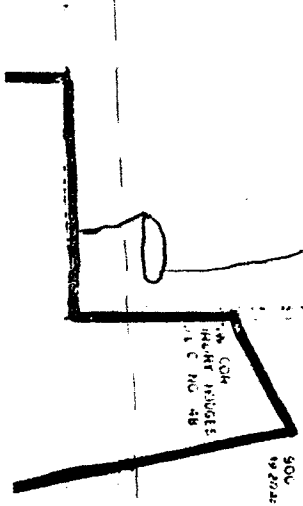

Permit No.

REGISTRATION NO. R84806

16, 15  
21, 22

Beginning of Pond II  
is located 1300' E  
AAD 1500 N  
Section Corner

Tax lot 1400  
700

RECEIVED

JUL 17 2001

WATER RESOURCES DEPT.  
SALEM, OREGON

Quarter/quarters

SW

10 4