
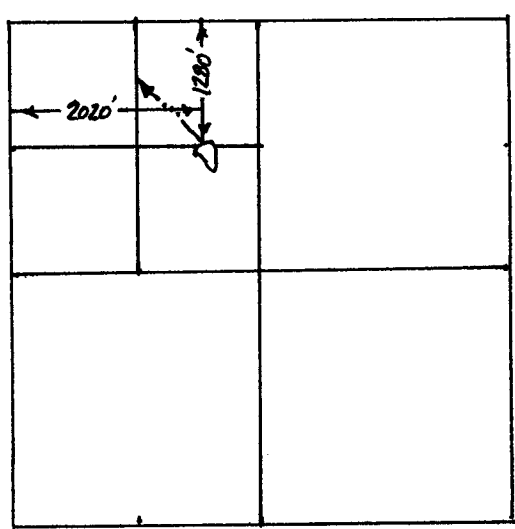


RECEIVED  
AUG 31 2001  
WATER RESOURCES DEPT  
SALEM, OREGON

COLUMBIA EMPIRE FARMS, INC  
R-2 RANCH POND # 8  
T. 9 S., R. 15 E., W. M.  
SECTION 22

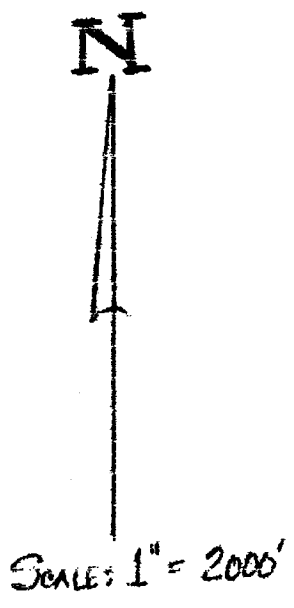

Application No. R 84894  
Permit No. R-13266