


RECEIVED
AUG 31 2001
WATER RESOURCES DEP
SALEM, OREGON


COLUMBIA EMPIRE FARMS, INC
R-2 RANCH POND # 17

T. 8 S., R. 15 E., W.M.

SECTION 21

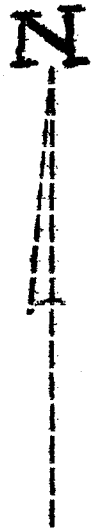

SCALE: 1" = 2000'

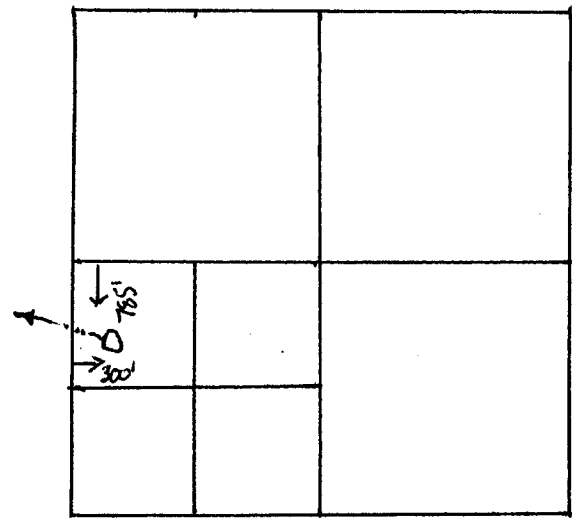

Application No. R 84900
Permit No. R-13271