T18, R6W, Sec. 2

POLK COUNTY

1" = 800'

SEE MAP NO 6 6 35

7 6 2

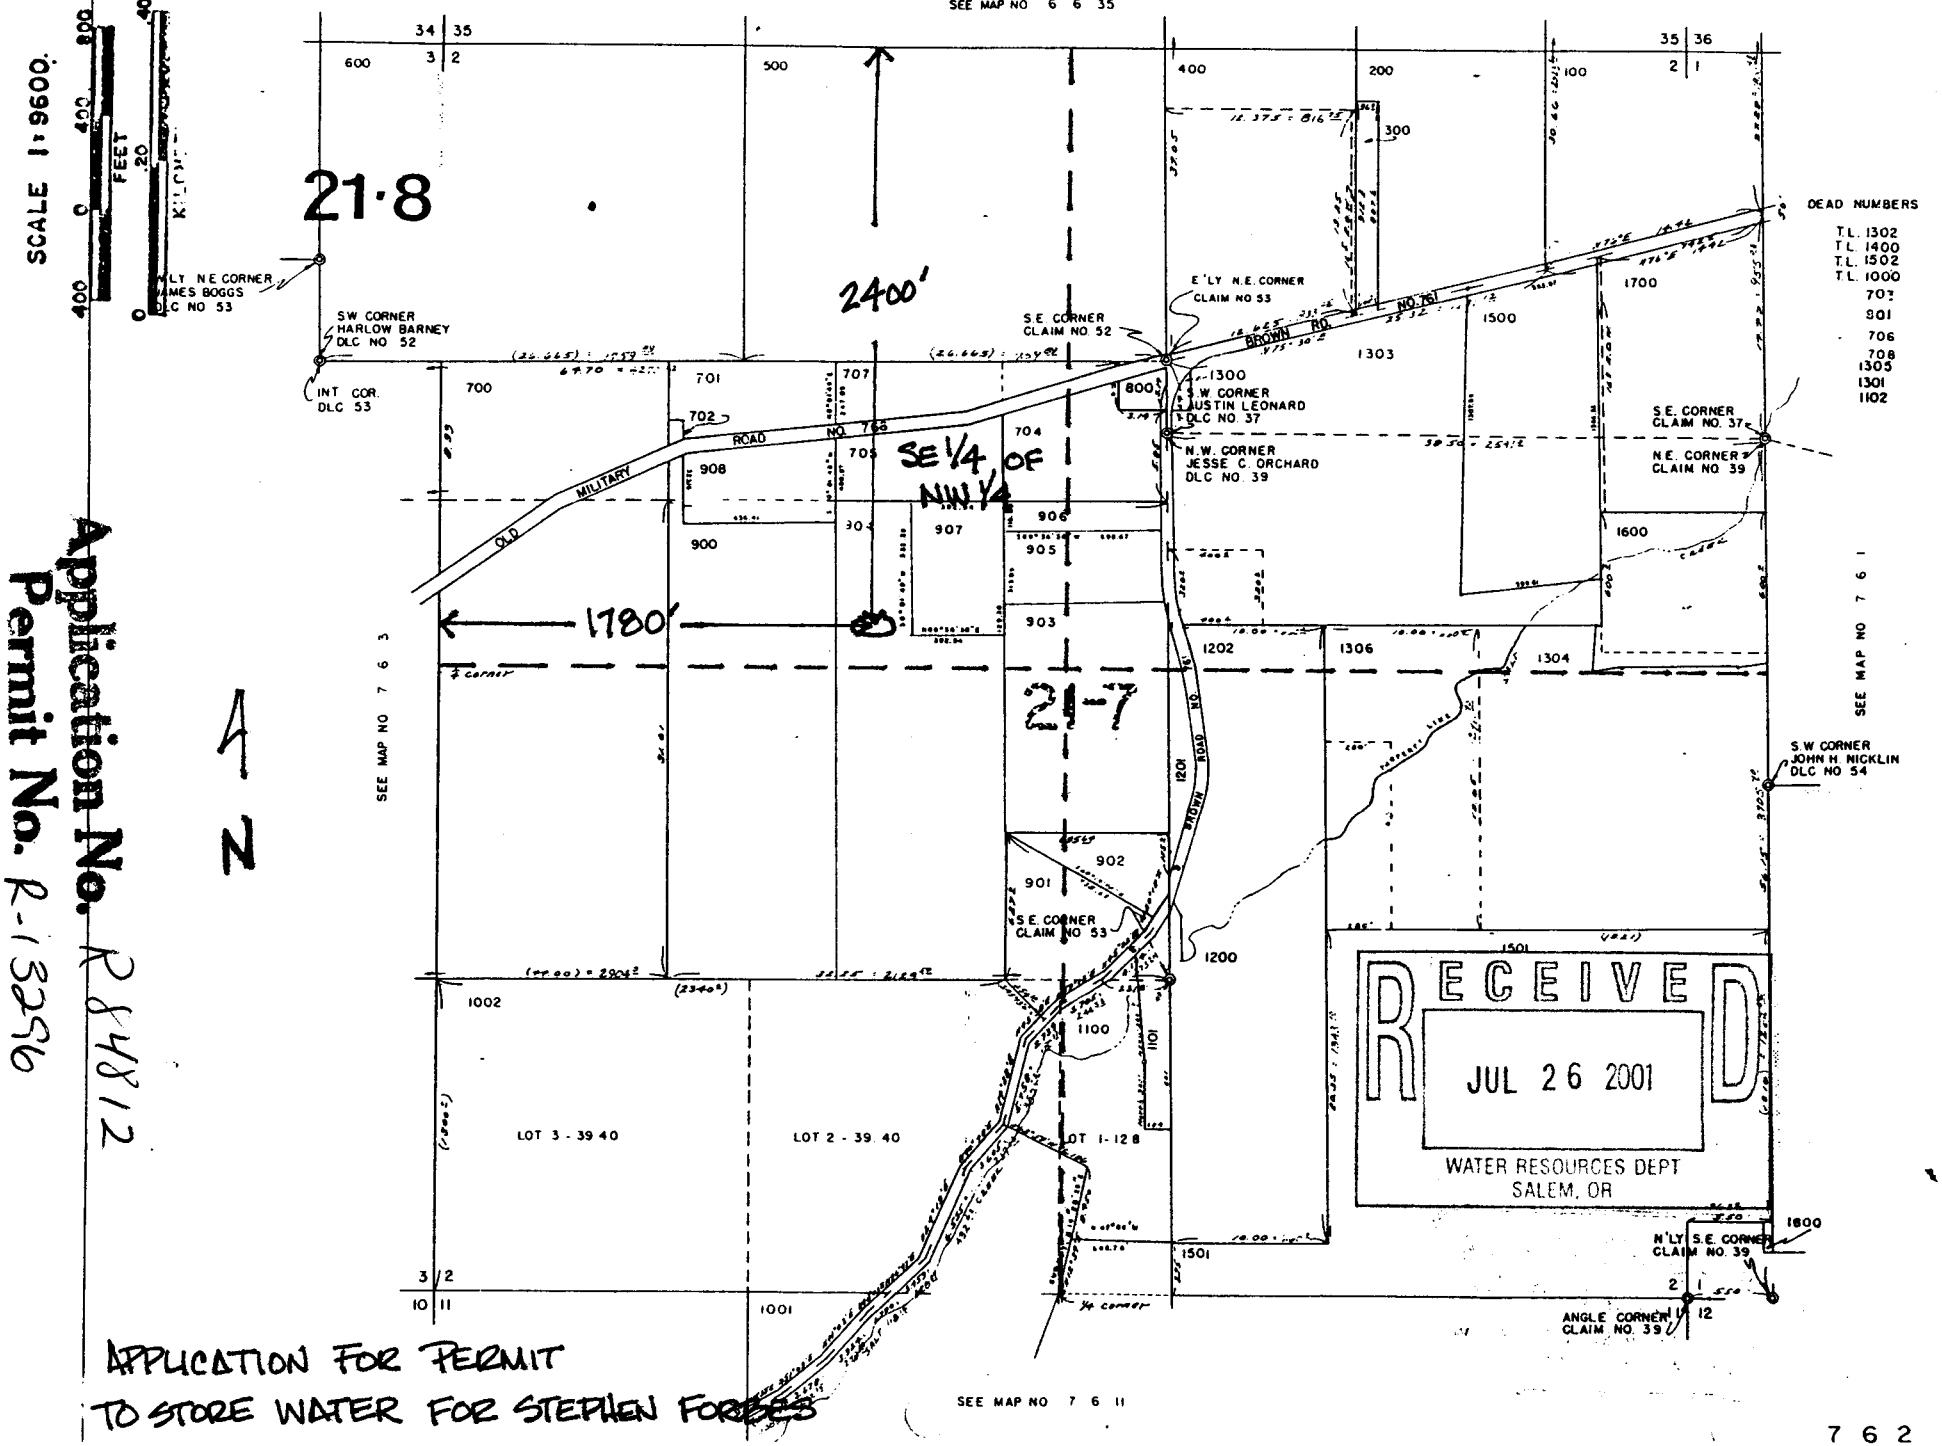

RECEIVED
JUL 26 2001
WATER RESOURCES DEPT
SALEM, OR

Application No. R48812
Permit No. R-13296

APPLICATION FOR PERMIT
TO STORE WATER FOR STEPHEN FORBES

7 6 2