

RECEIVED

AUG 31 2001

WATER RESOURCES DEPT  
SALEM, OREGON

COLUMBIA EMPIRE FARMS, INC  
R-2 RANCH POND # 23


T. 6 S., R. 15 E., W.M.

SECTION 19

N



Scale: 1" = 2000'

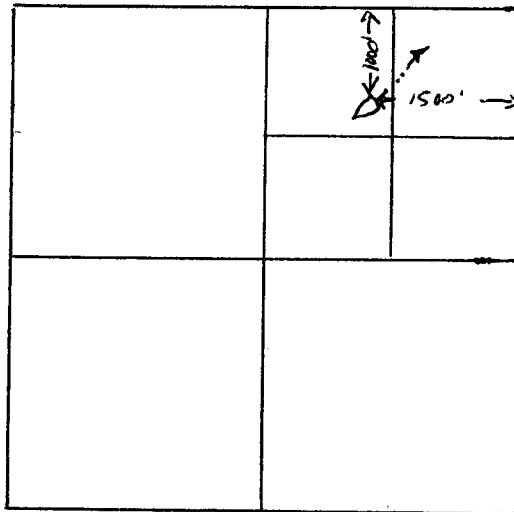

Application No. R84905  
Permit No. R-13298