


RECEIVED
AUG 31 2001
WATER RESOURCES DEPT
SALEM, OREGON

COLUMBIA EMPIRE FARMS, INC
R-2 RANCH POND # 27
T. 7 S., R. 15 E., W.M.
SECTION 4

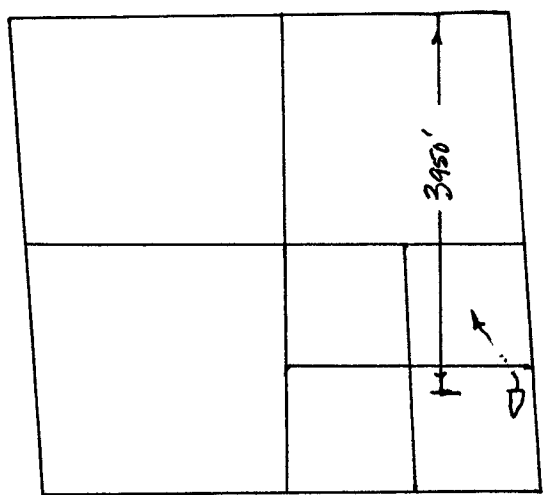

SCALE: 1" = 2000'



Application No. R84908
Permit No. R-13300