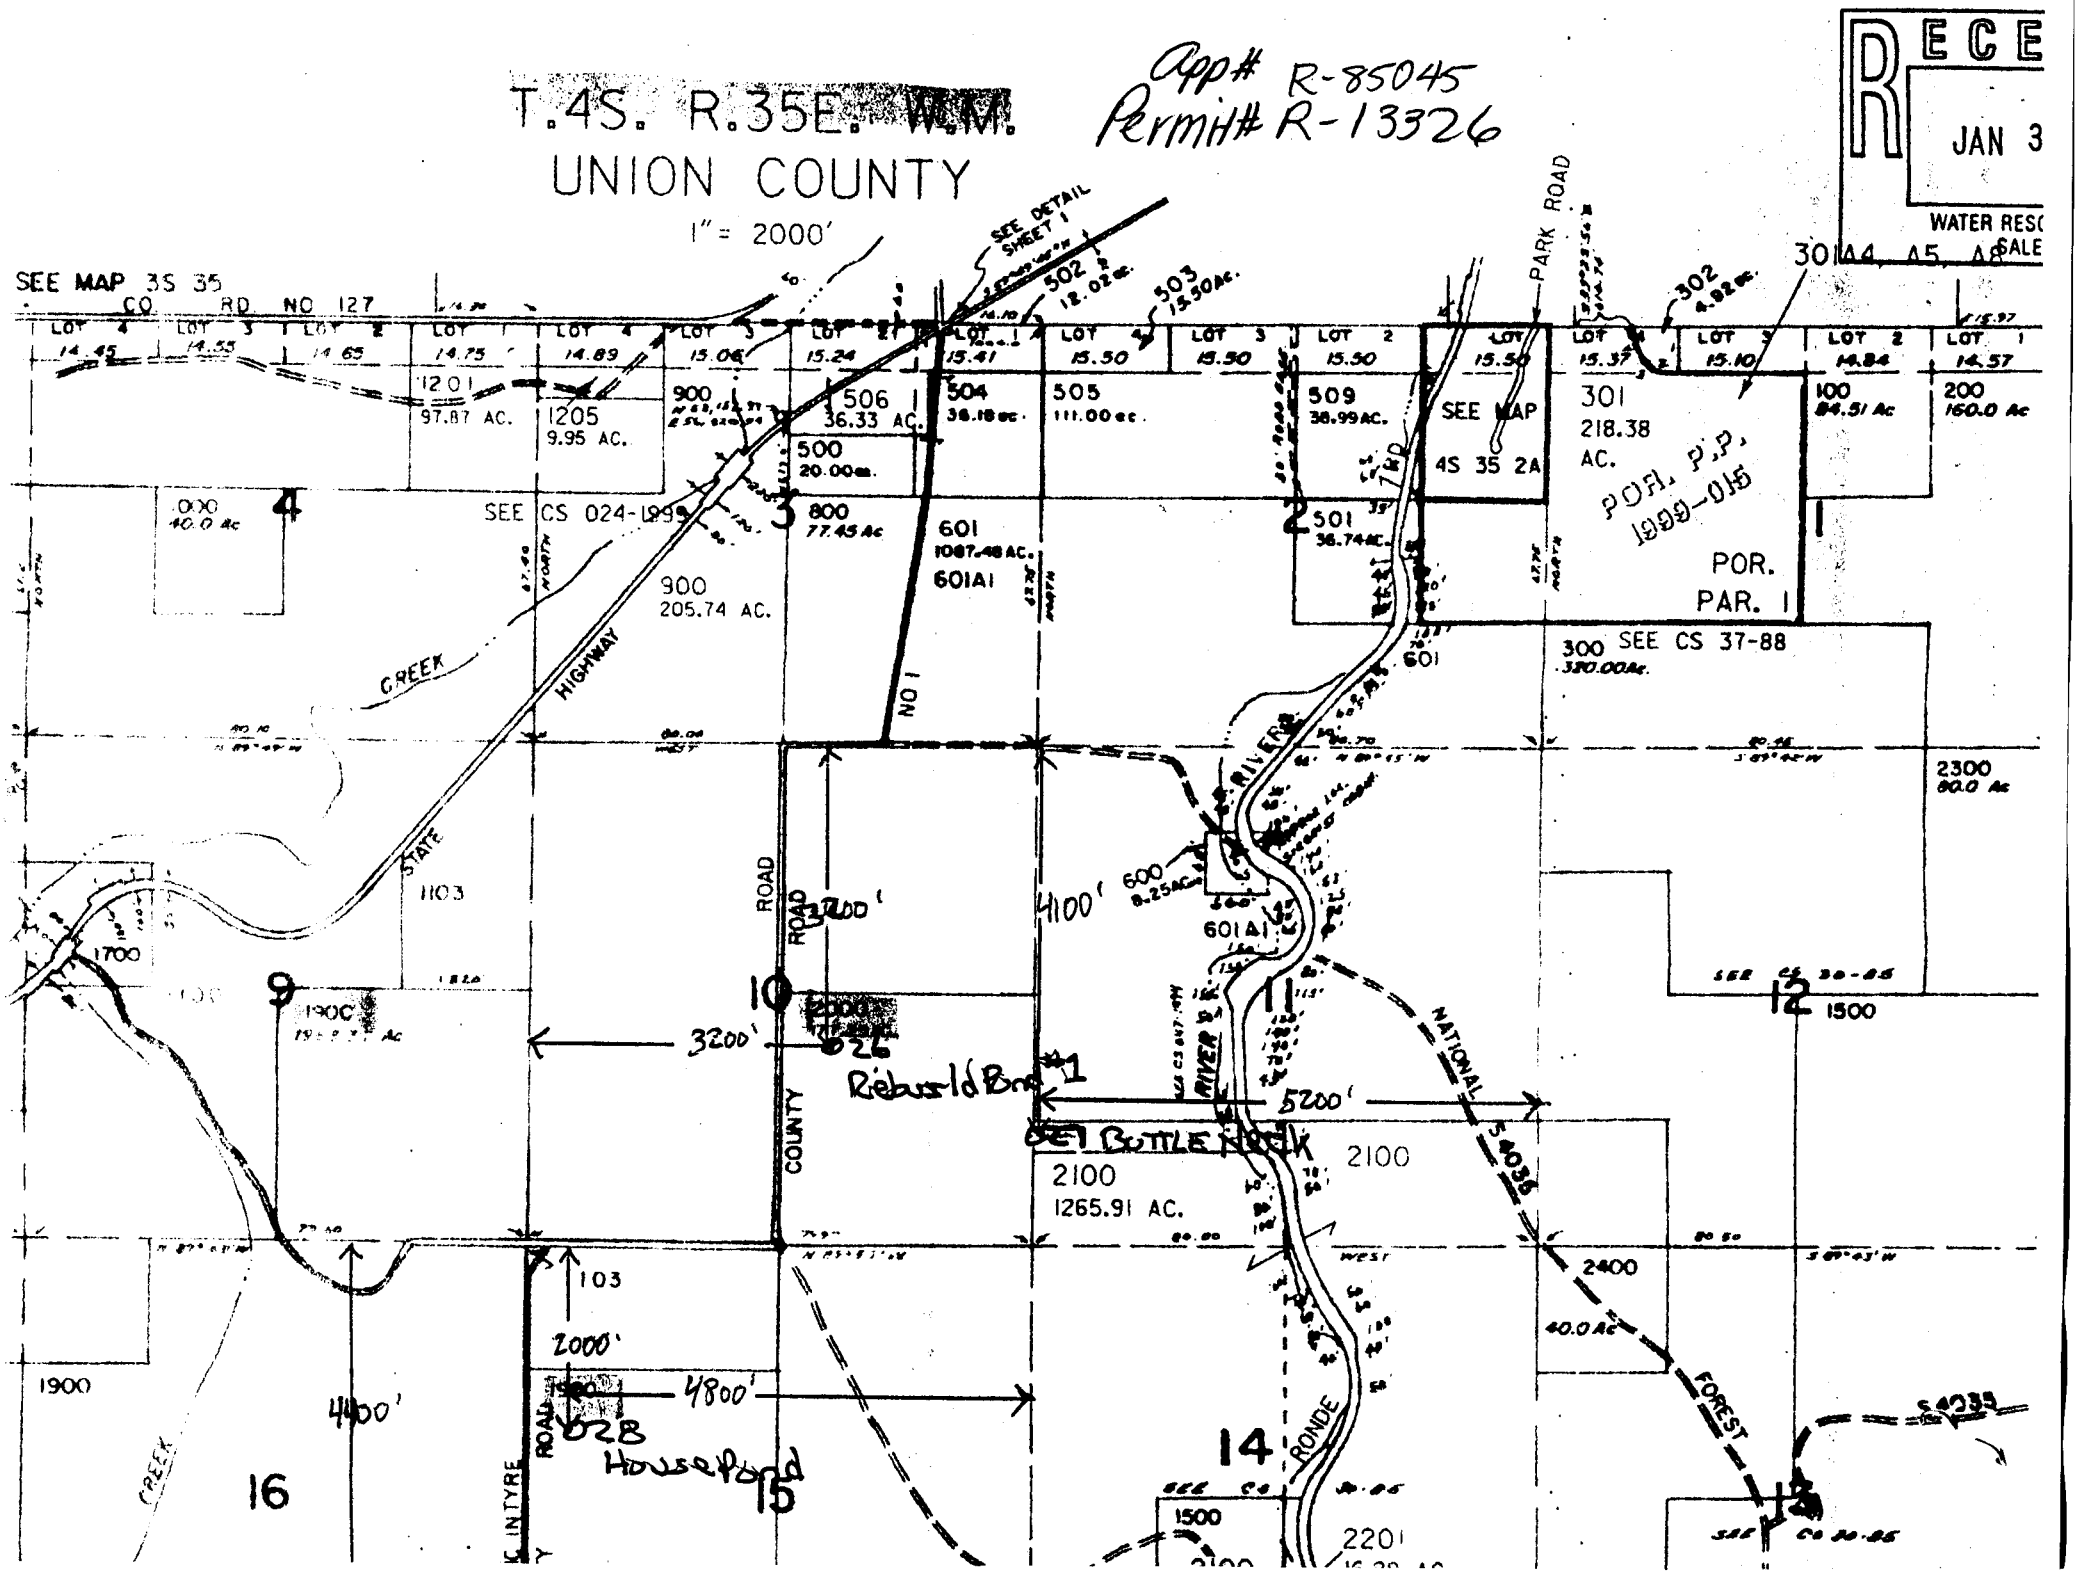
T.4S. R.35E. W.M.
UNION COUNTY
1" = 2000'
App# R-85045
Permit# R-13326
RECE
JAN 3
WATER RESC
SALE
SEE MAP 3S 35
CO RD NO 127
SEE DETAIL SHEET 1
PARK ROAD
SEE MAP 4S 35 2A
POR. PAR. 1
POR. P.P. 1999-015
SEE CS 024-99
SEE CS 37-88
HIGHWAY
CREEK
STATE
ROAD
COUNTY
NO 1
RIVER
BOTTLE
NATIONAL
FOREST
RONDE
K. INTYRE
Reburld Brg #1
Housepond
3200'
4100'
5200'
2000'
4800'
4000'
103
628
626
1265.91 AC.
97.87 AC.
9.95 AC.
36.33 AC.
111.00 ac.
38.99 AC.
218.38 AC.
205.74 AC.
1087.48 AC.
38.74 AC.
320.00 Ac.
1700
1900
2100
2200
2300
2400
1500
1205
1201
506
504
505
509
301
302
100
200
300
400
500
600
601
601A1
800
900
1000
1100
1103
1900C
2201
5403
5403S
LOT 4
LOT 3
LOT 2
LOT 1
14.45
14.55
14.65
14.75
14.89
15.06
15.24
15.41
15.50
15.37
15.10
14.84
14.57
4
3
2
1
9
10
11
12
14
15
16