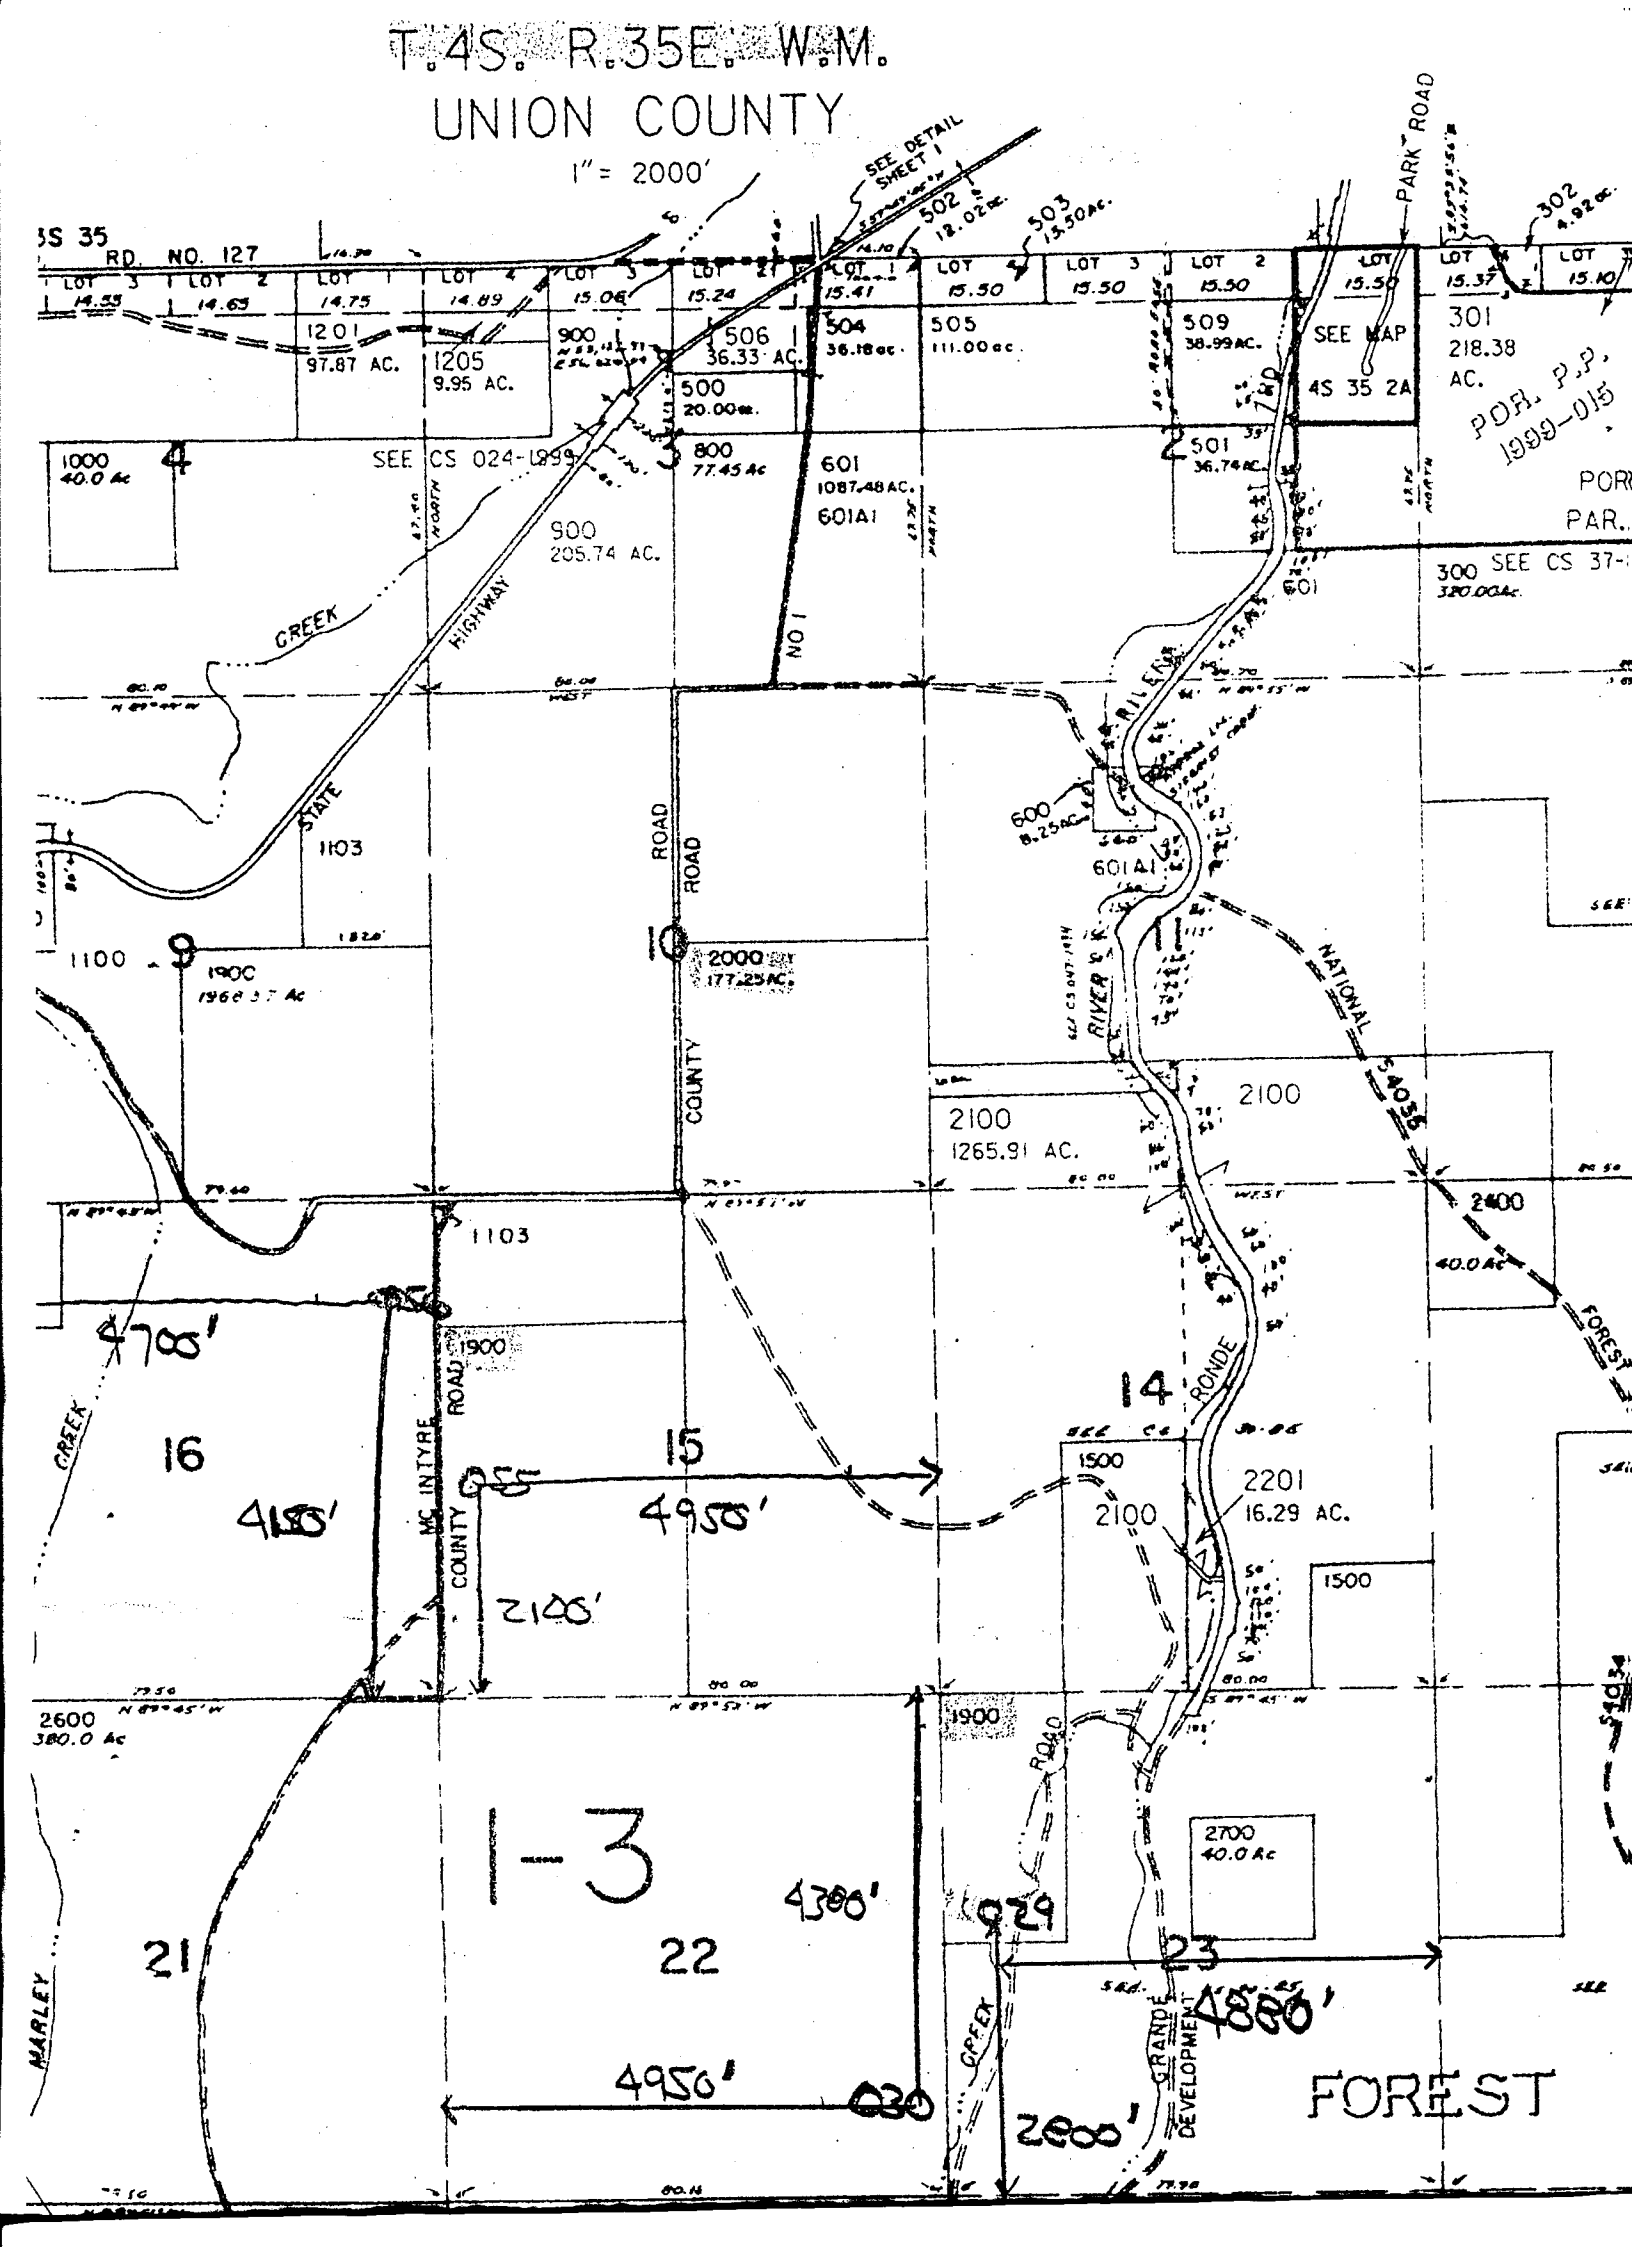
T. 4S. R. 35E. W.M.
UNION COUNTY
1" = 2000'
SEE DETAIL SHEET 1
PARK ROAD
RD. NO. 127
LOT 3 14.55
LOT 2 14.65
LOT 1 14.75
LOT 4 14.89
LOT 3 15.06
LOT 2 15.24
LOT 1 15.41
LOT 15.50
LOT 3 15.50
LOT 2 15.50
LOT 15.50
LOT 15.37
LOT 15.10
1201 97.87 AC.
1205 9.95 AC.
900
506 36.33 AC.
500 20.00 ac.
502 12.02 ac.
503 13.50 AC.
504 36.18 ac.
505 111.00 ac.
509 38.99 AC.
SEE MAP 4S 35 2A
302 4.92 ac.
301 218.38 AC.
POR. P.P. 1999-015
1000 40.0 Ac
SEE CS 024-1999
800 77.45 Ac
601 1087.48 AC.
601A1
501 36.74 AC.
900 205.74 AC.
300 SEE CS 37-
320.00 Ac.
601
GREEK
HIGHWAY
NO 1
RILEY
600 8.25 AC.
STATE
1103
ROAD
COUNTY
1100
1900 196.63 Ac
2000 177.25 AC.
RIVER
NATIONAL
2100 1265.91 AC.
2100
2400 40.0 Ac
FOREST
1103
4780'
950'
1900
RONDE
14
GREEK
16
4150'
15
4950'
MC INTYRE ROAD
COUNTY
950'
2100'
1500
2100
2201 16.29 AC.
1500
2600 380.0 Ac
1900
1-3
4300'
ROAD
2700 40.0 Ac
929'
21
22
23
4880'
MARLEY
GREEK
GRANDE DEVELOPMENT
4950'
930'
2600'
FOREST