

app # R-85048

Permit # R-13329


T.4S. R.35E. W.M.

UNION COUNTY

1" = 2000'

SEE MAP 35 35

CO. RD. NO 127

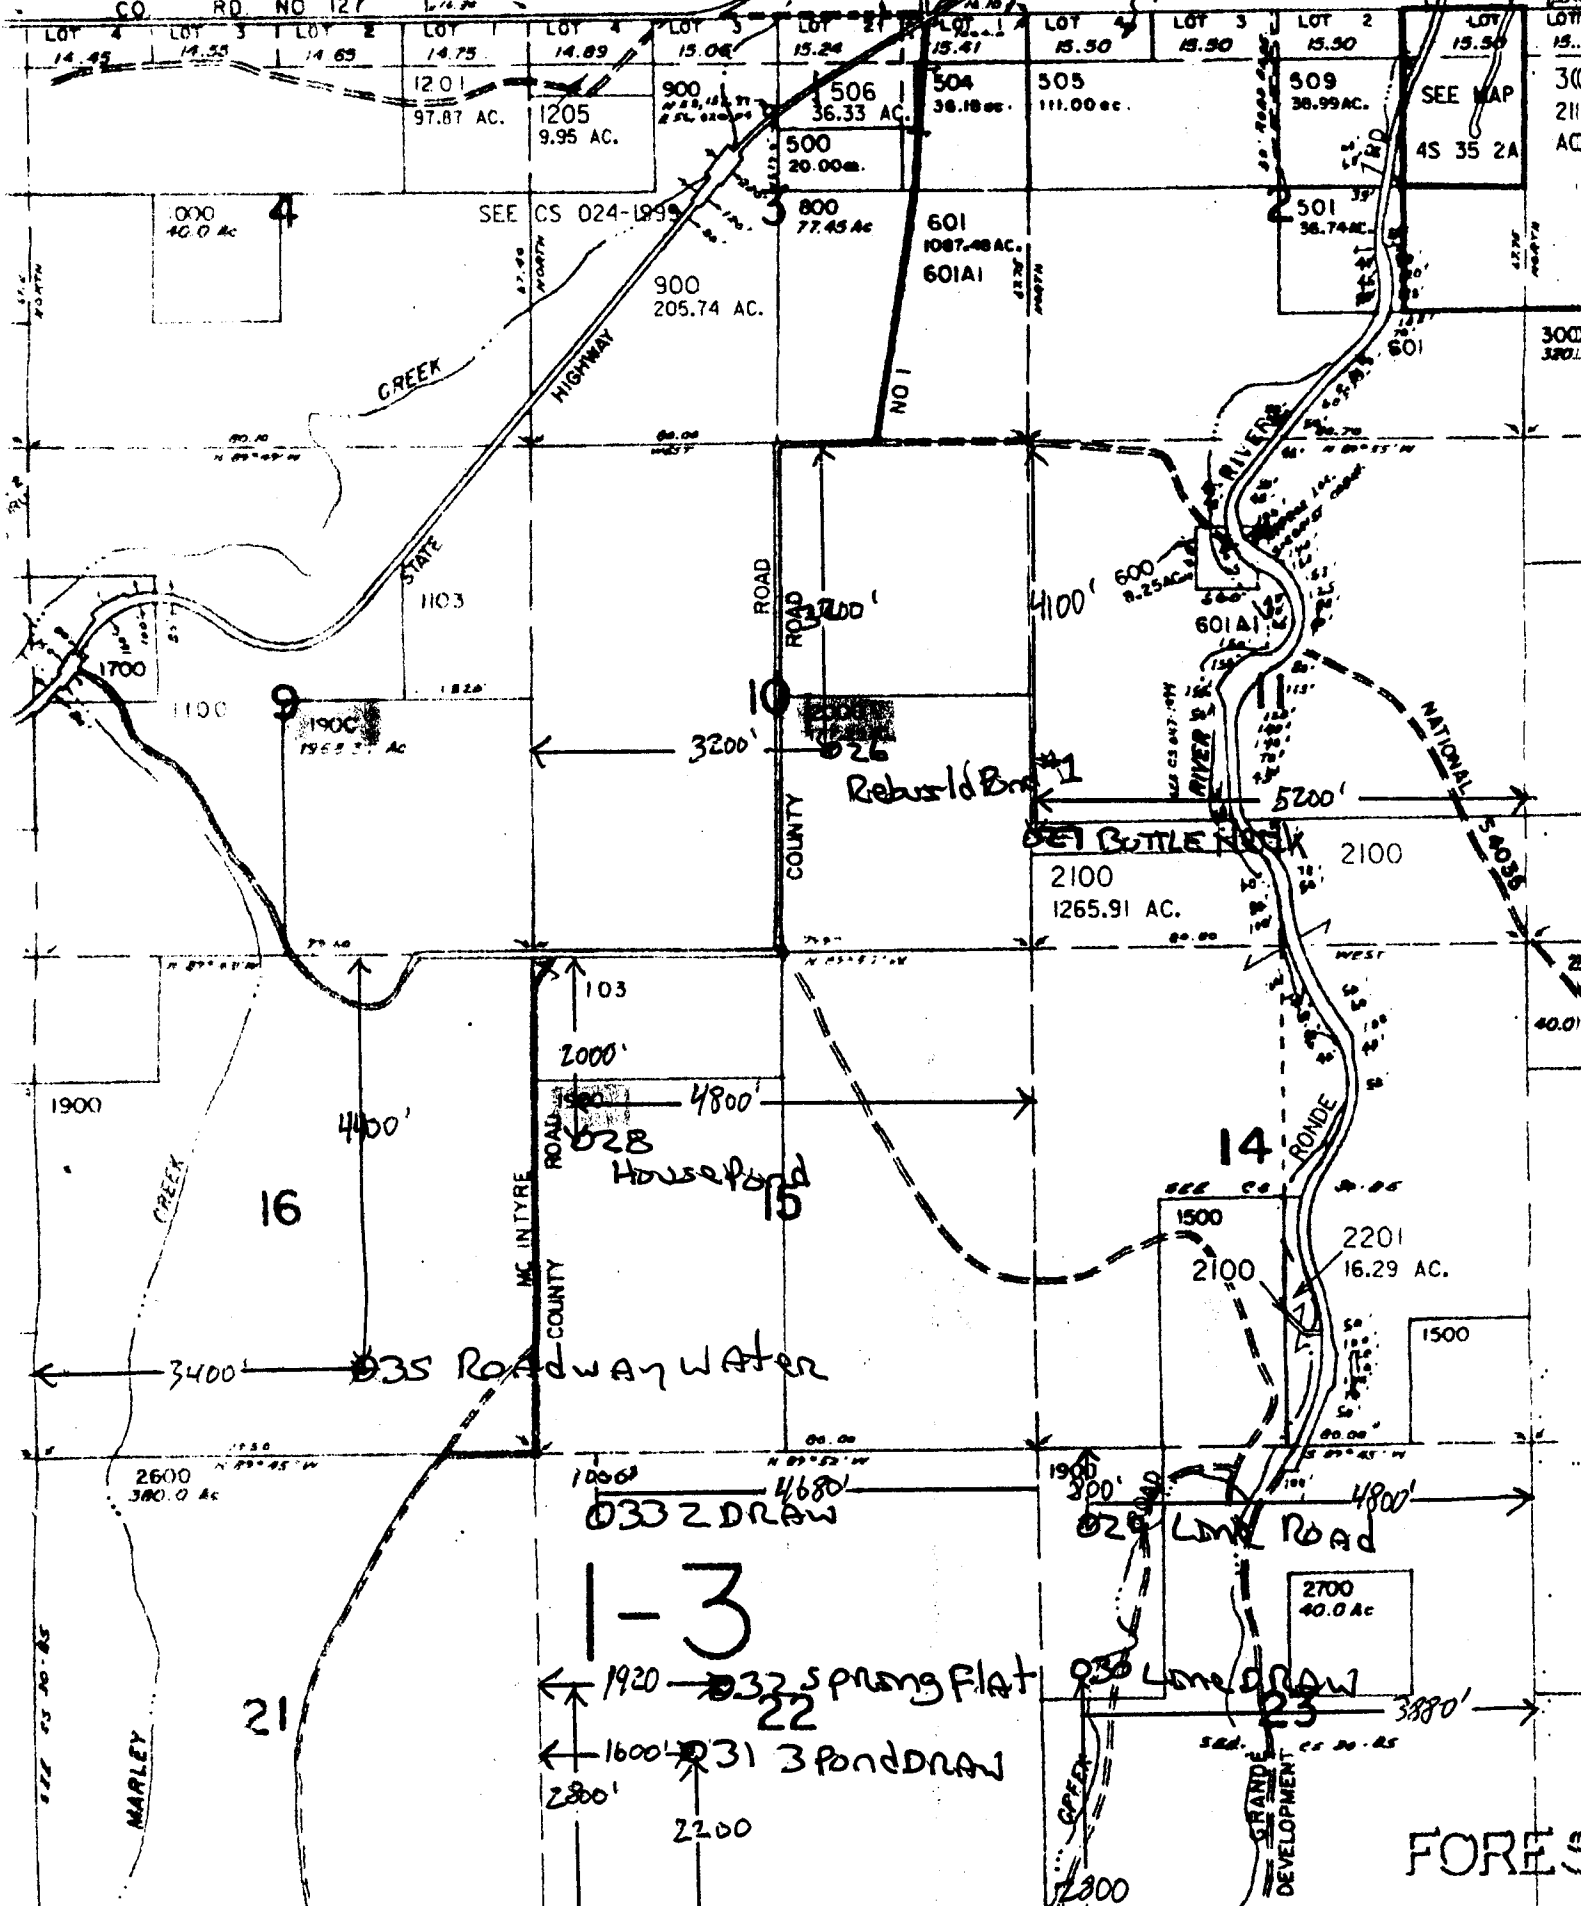

1-3





FOREC