


T.4S. R.35E. W.1M.
UNION COUNTY

App# R-85049
Permit # R 13336

1" = 2000'

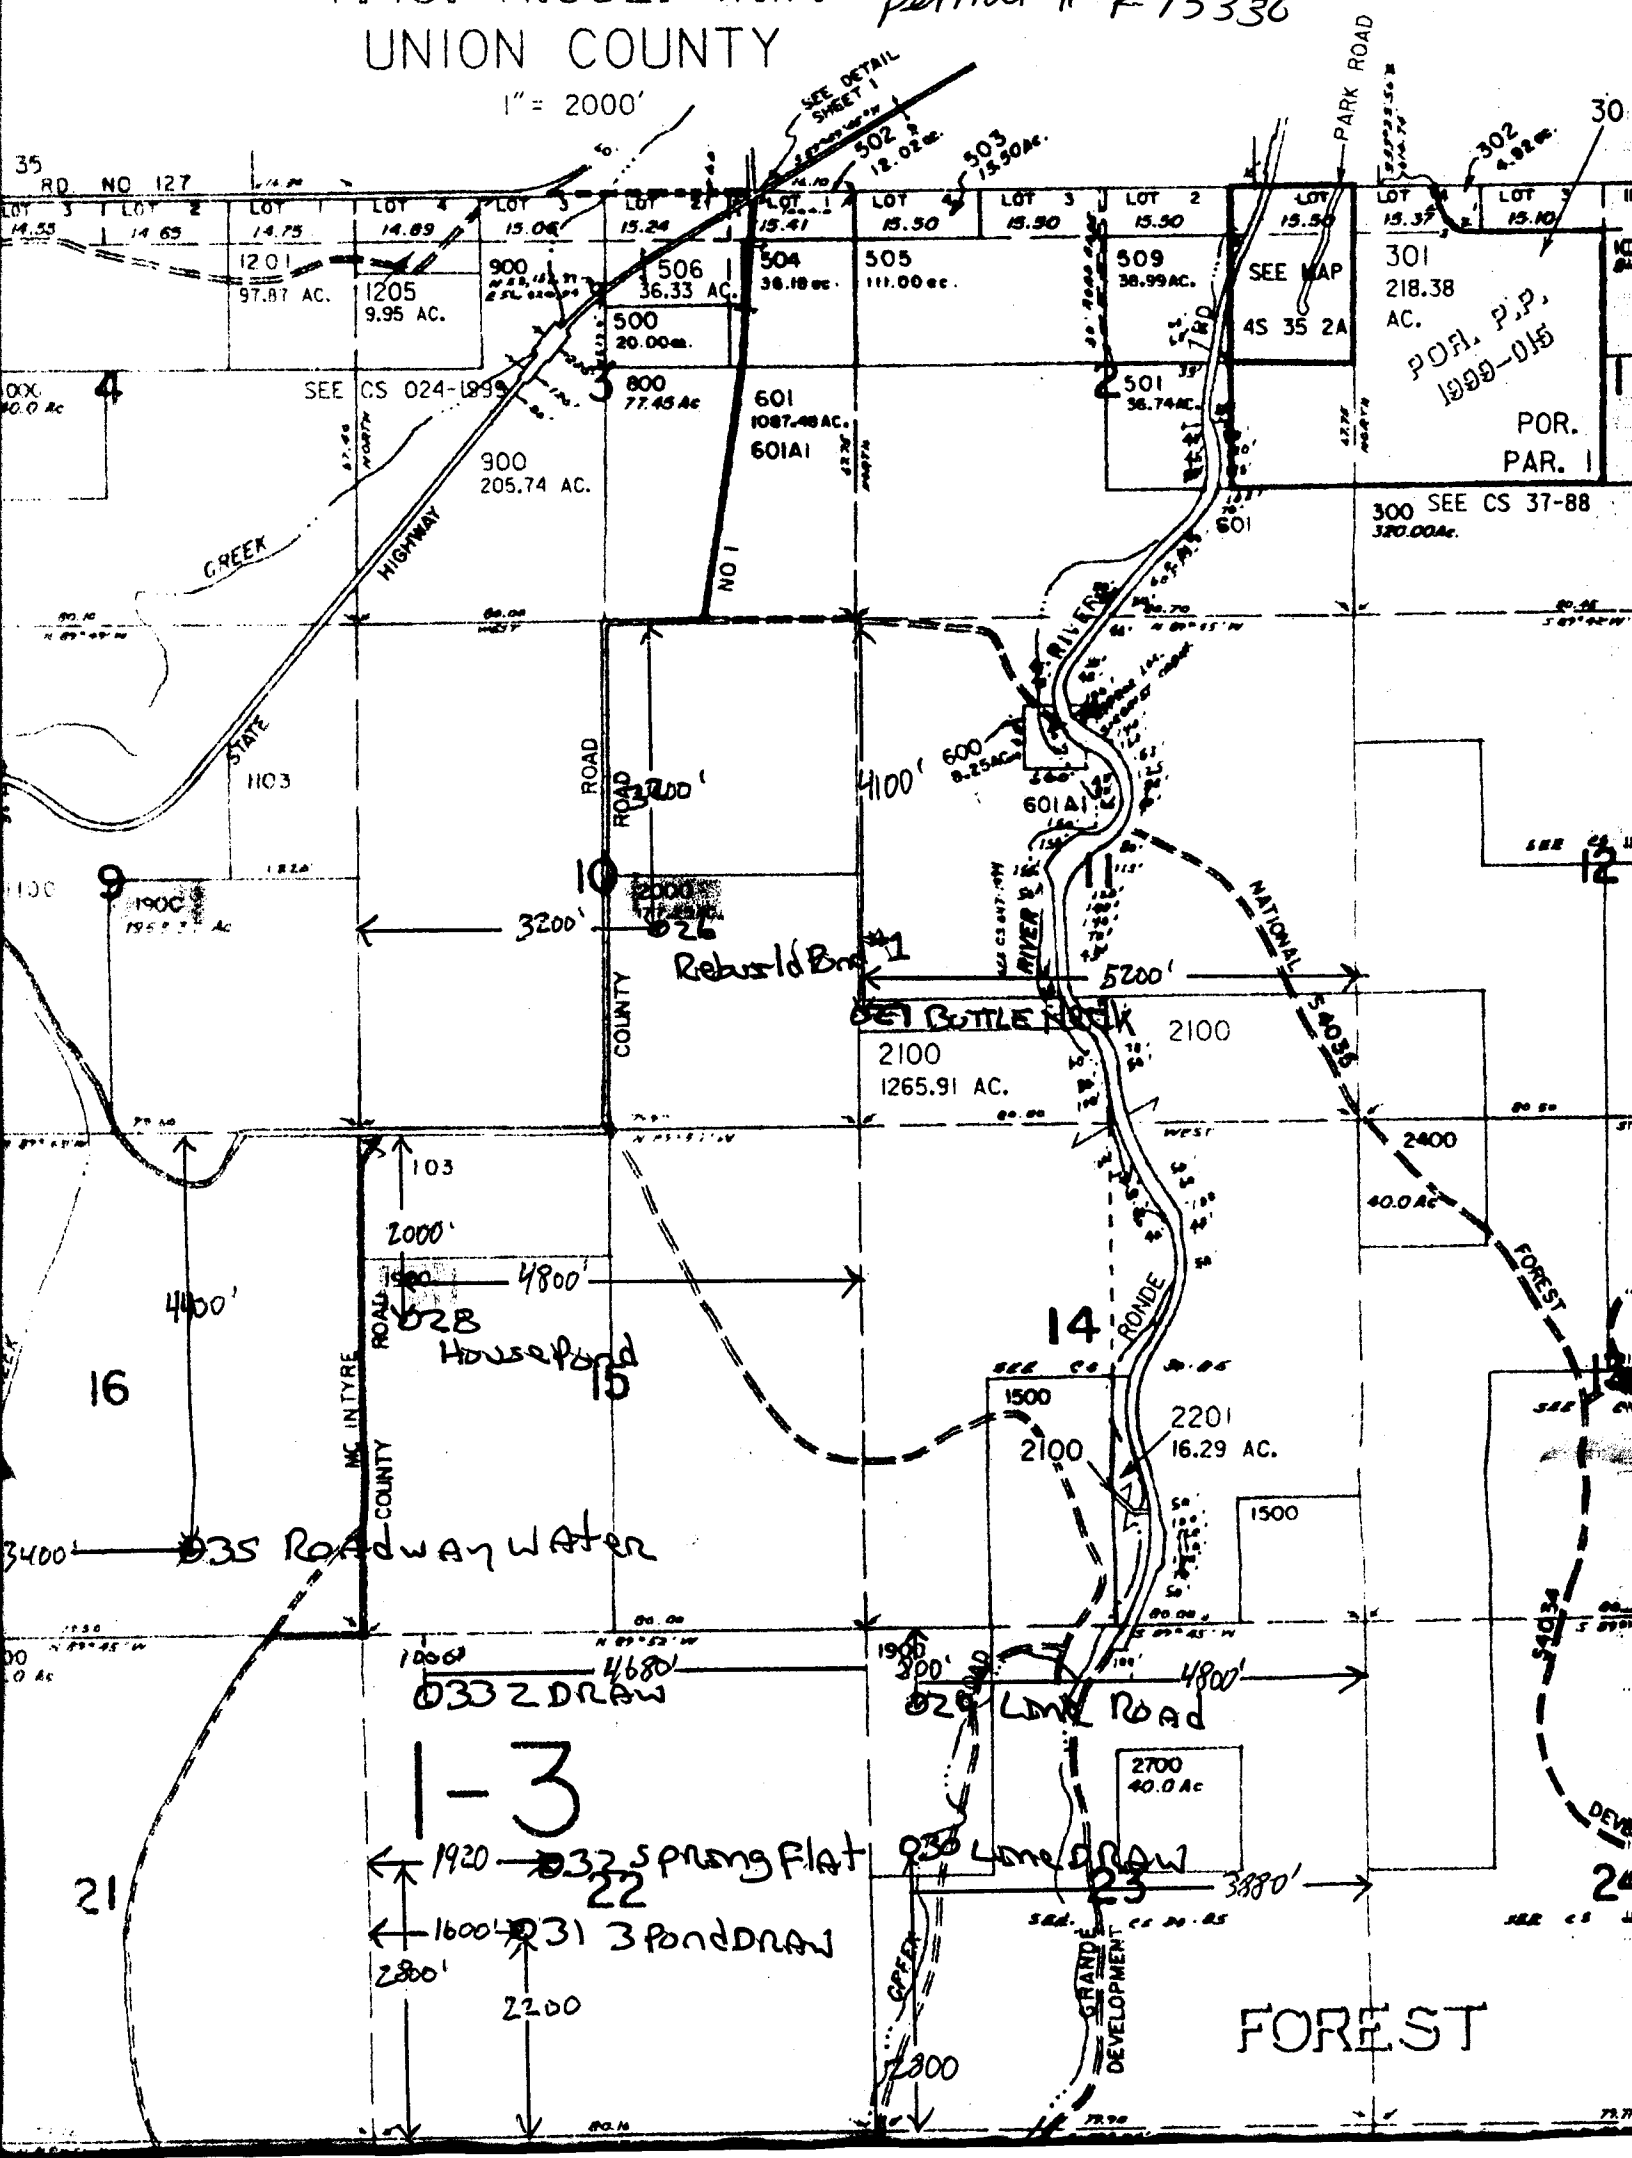

FOREST