app# R-85050
Permit# R-13331

T.4S. R.35E. W.M.

UNION COUNTY
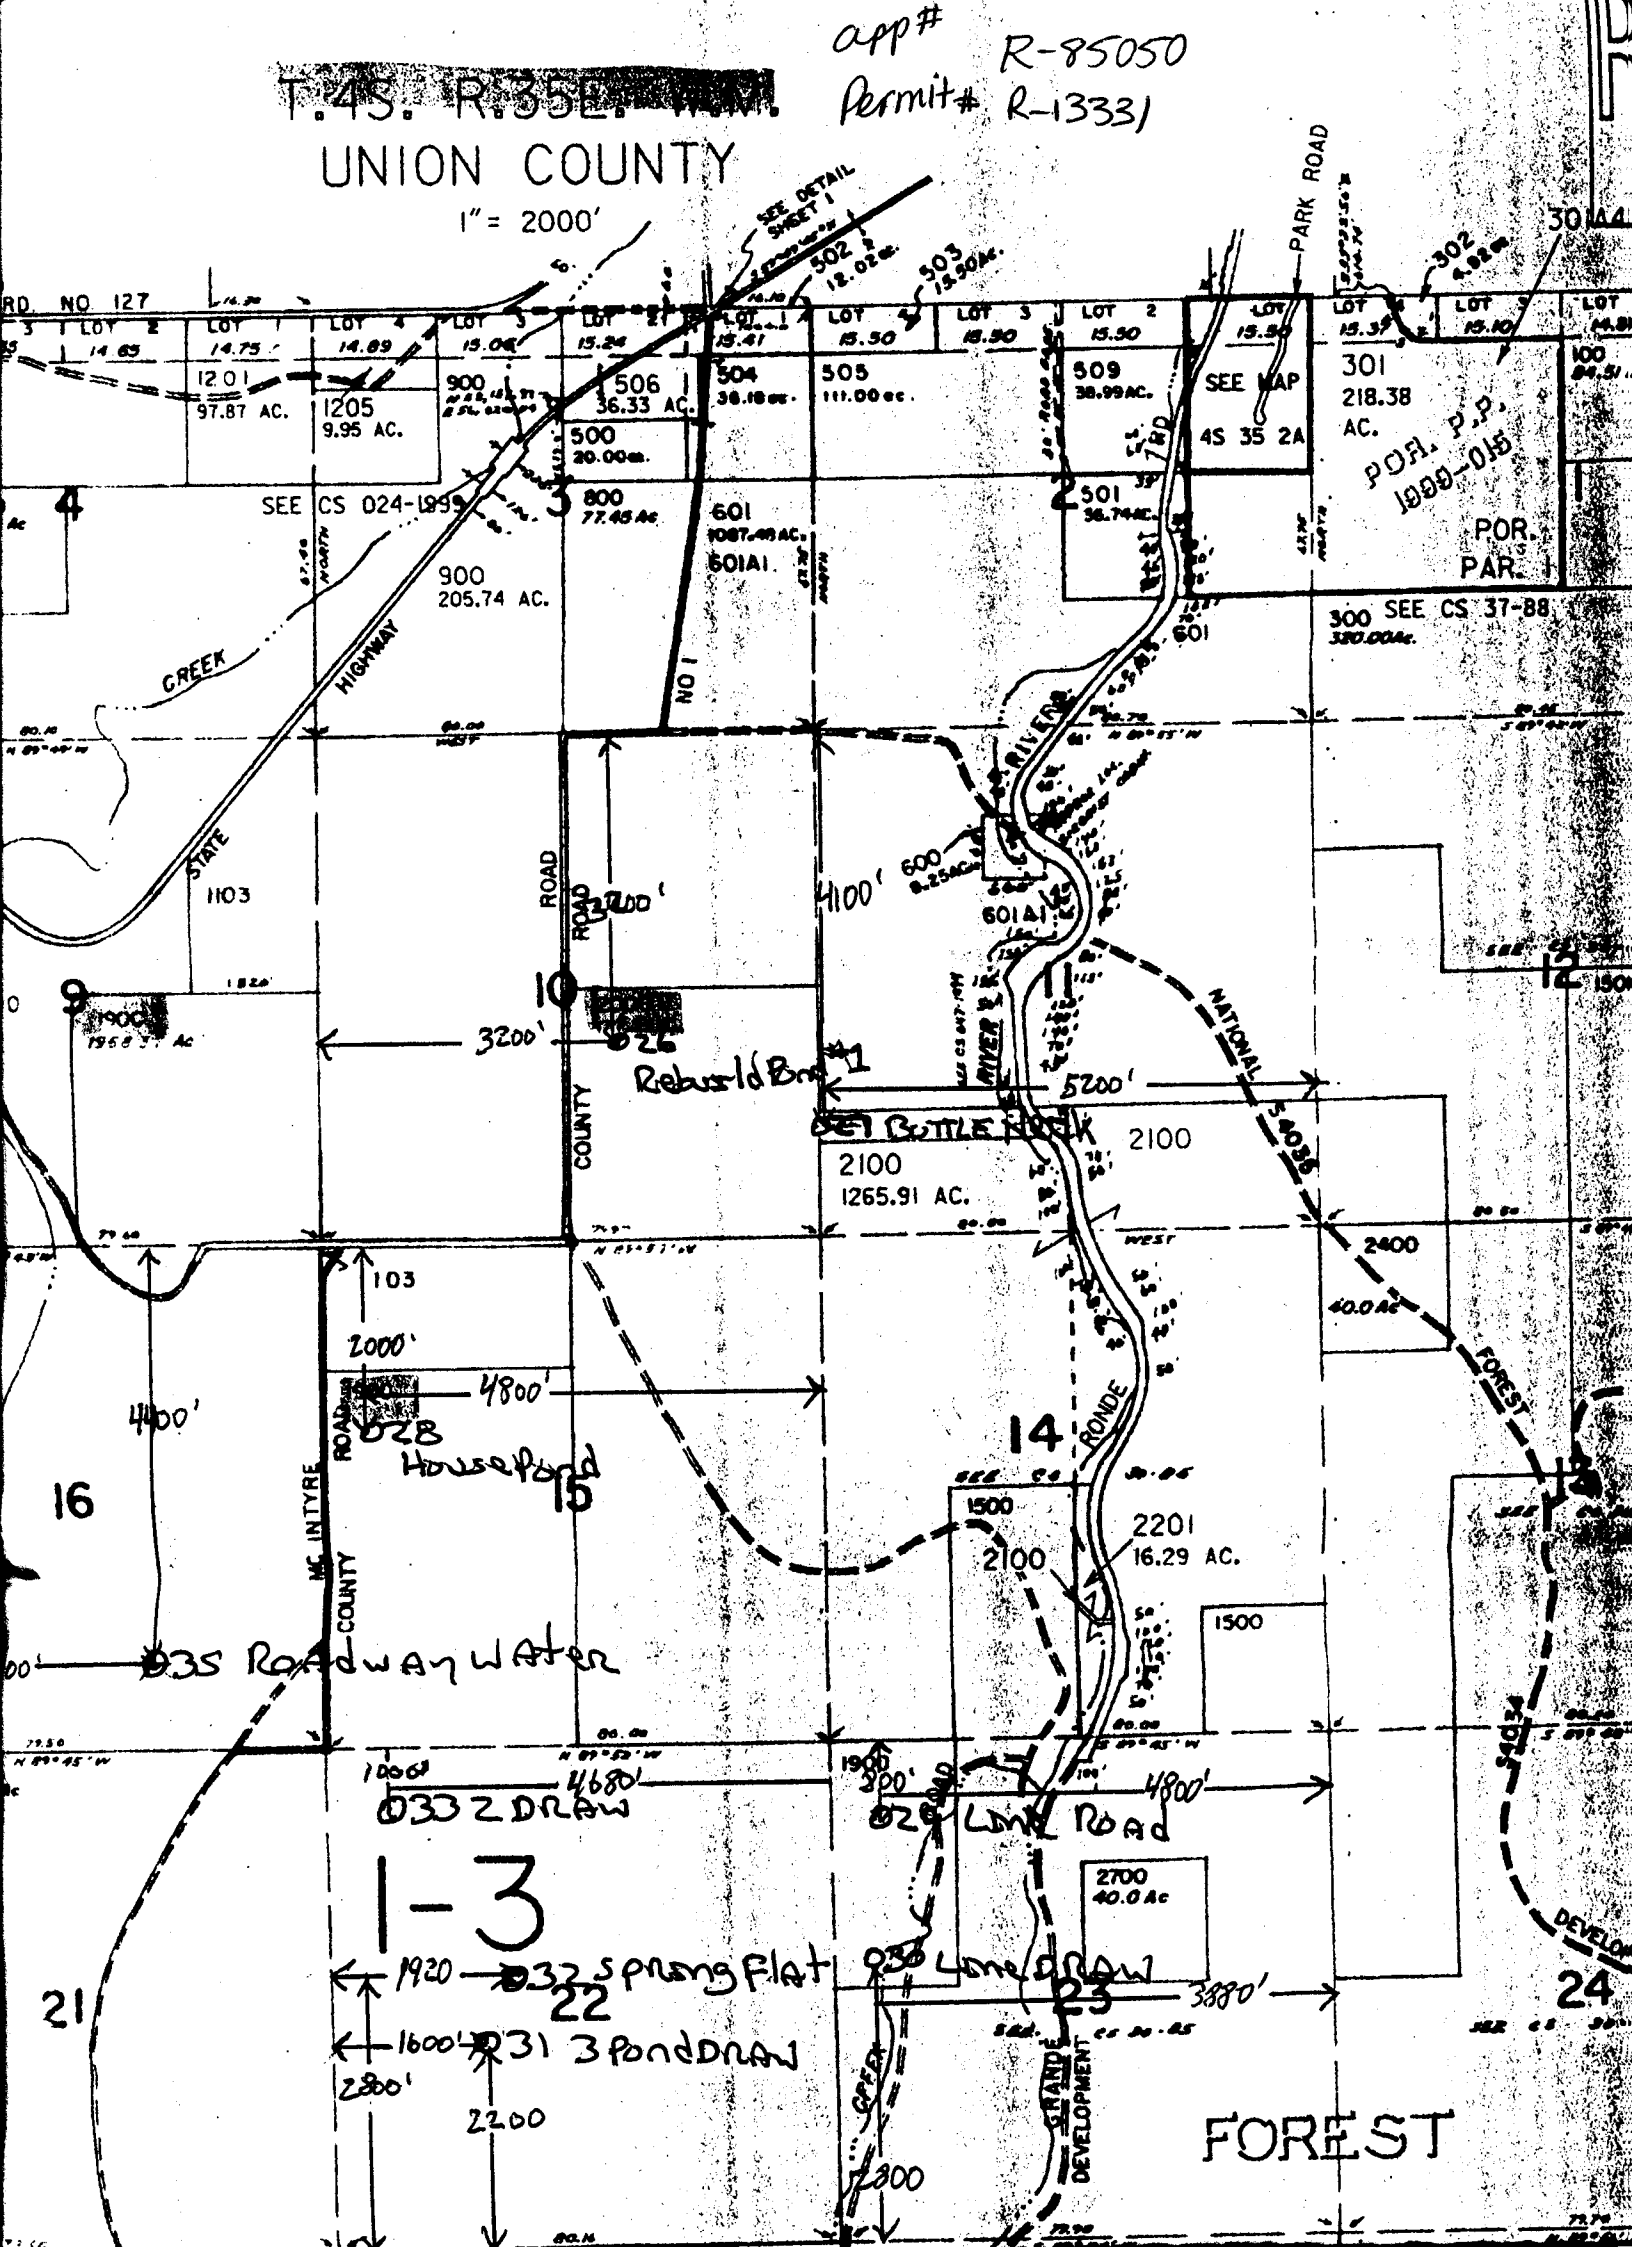
1" = 2000'