


Application No.

Permit No.

RECEIVED

APR 29 2002

WATER RESOURCES DEPT.
SALEM, OREGON

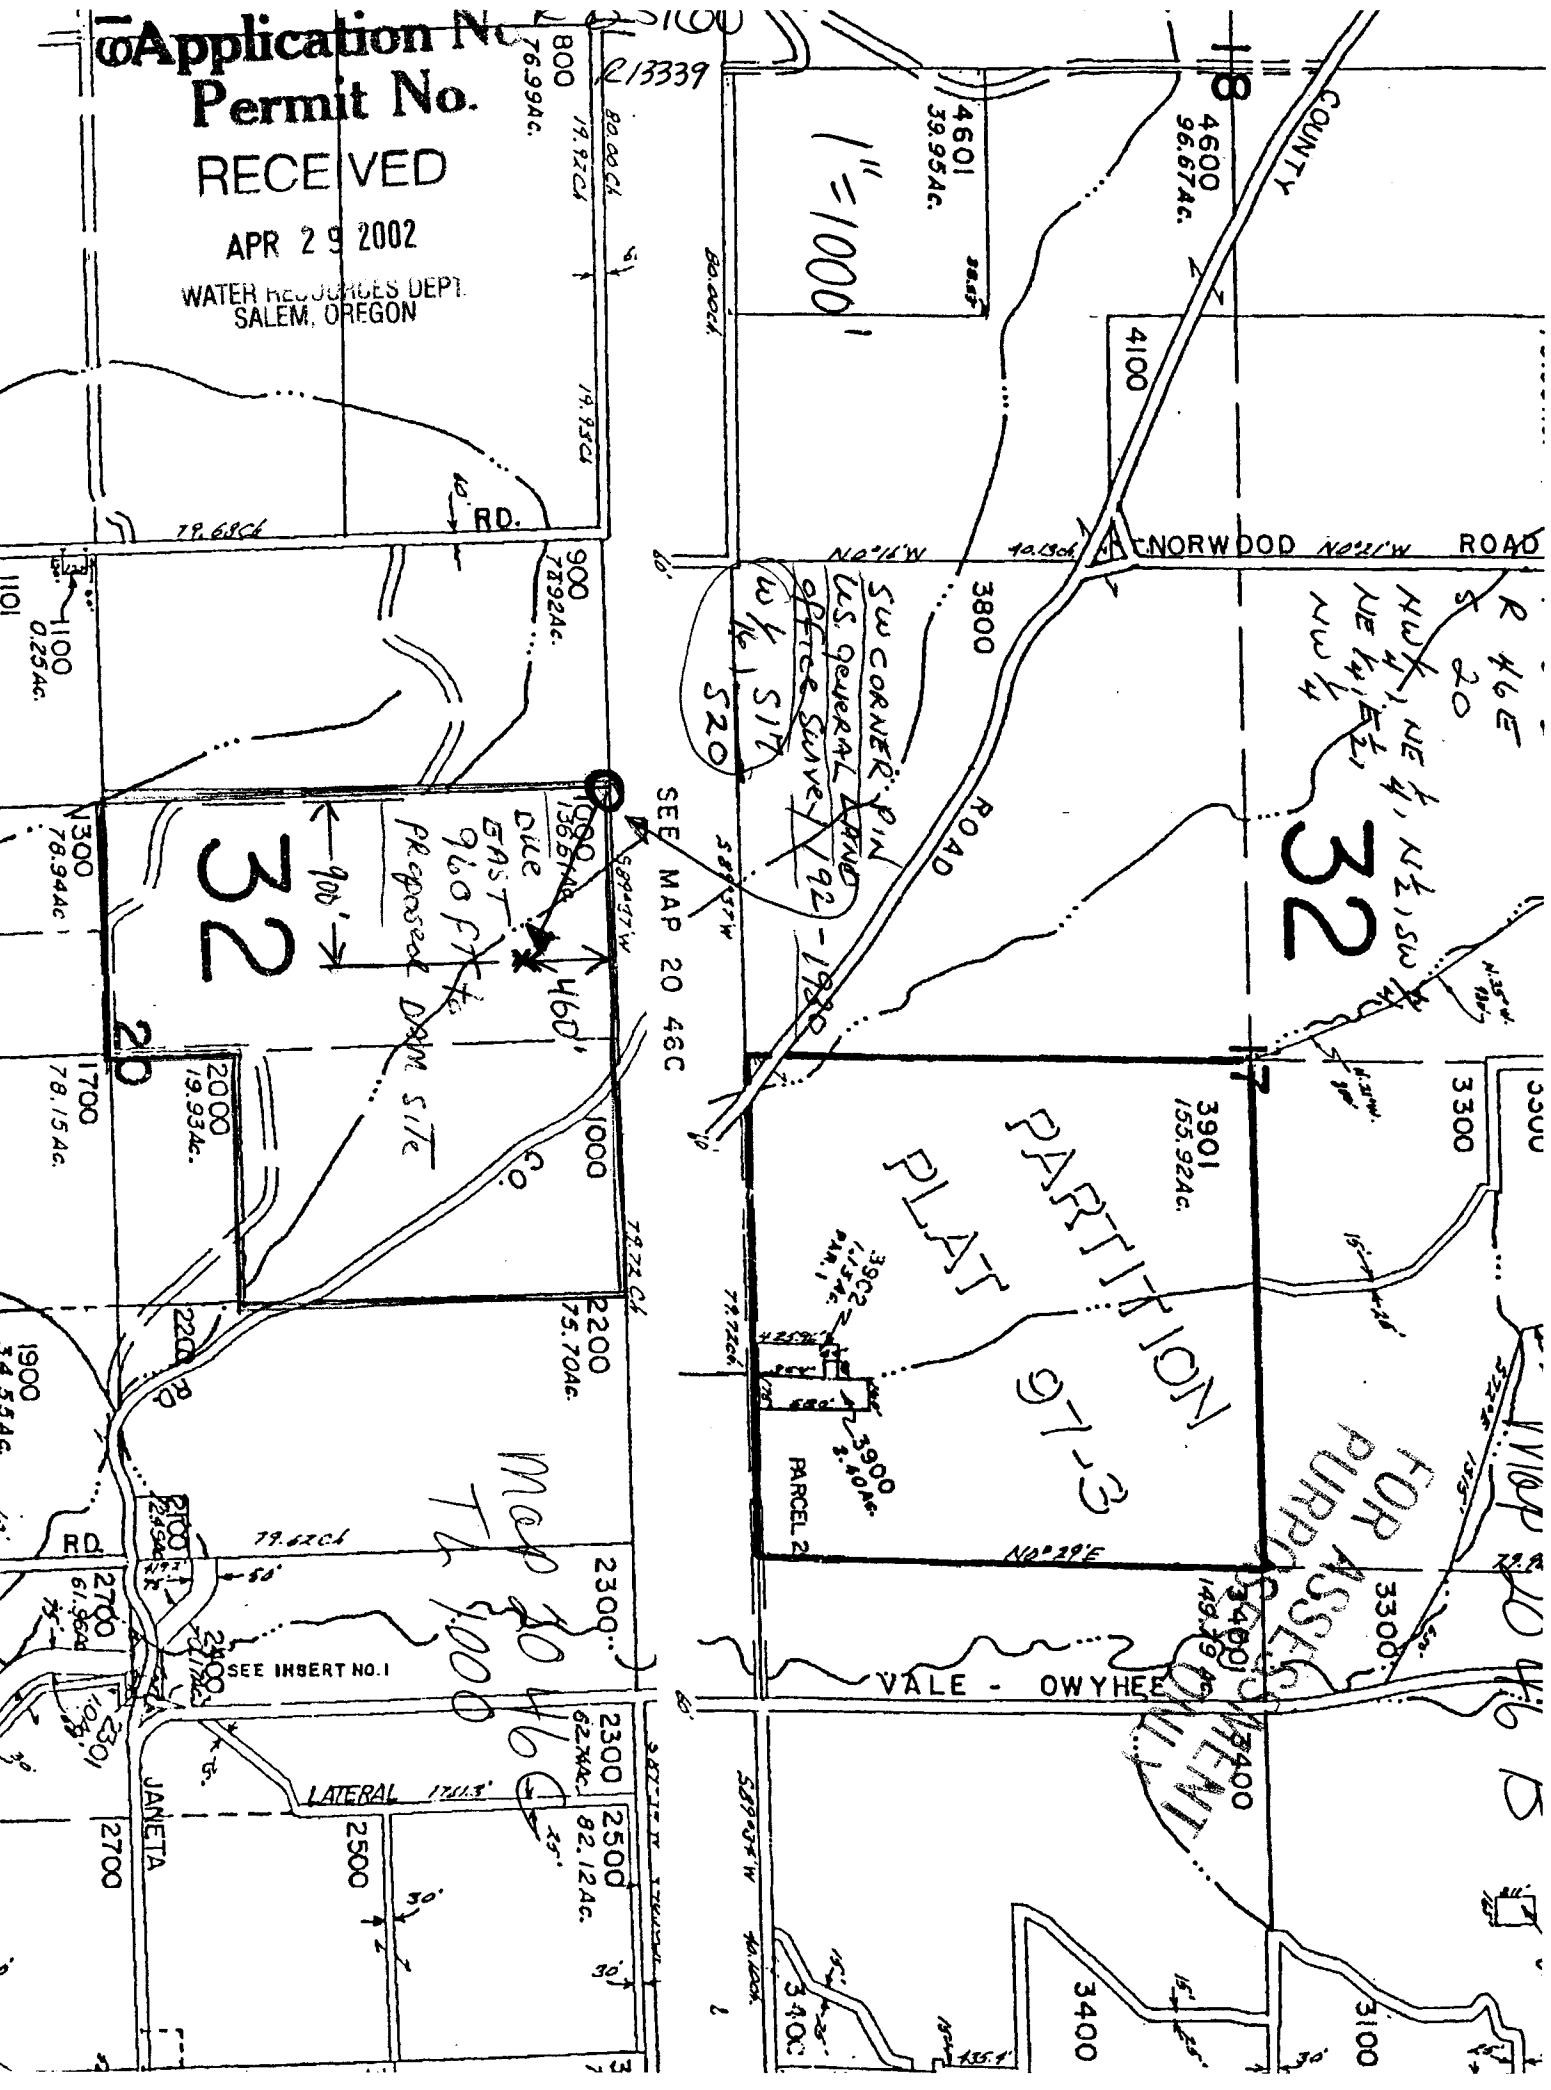

1" = 1000'

32

32

PLATT PARTITION 9-1-3

FOR ASSESSMENT PURPOSE

SEE MAP 20 48C

SEE INSERT NO. 1

Map 20 48C

LATERAL 1721.5'

76.994Ac. 800 17.92Ac. 19.93Ac. 79.68Ac. RD. 900 7892Ac. 1100 0.25Ac. 1300 78.94Ac. 1700 78.15Ac. 2000 19.93Ac. 2200 24.94Ac. 2700 61.96Ac. 1900 34.55Ac. 2300 62.7Ac. 2500 82.12Ac. 2700 JANETA

4600 96.67Ac. 4601 39.95Ac. 4100 3800 ROAD 3901 155.92Ac. 3300 3300 3300 3400 3400 3100 3400 VALE - OWYHEE ROAD 118 COUNTY

R 46 E
S 20
NW 1/4, NE 1/4, NE 1/4 SW 1/4

SW CORNER P.I.N.
US GENERAL LAND
OFFICE SURVEY 192-1982
w/ 1/2 S 17
520

PARCEL 2