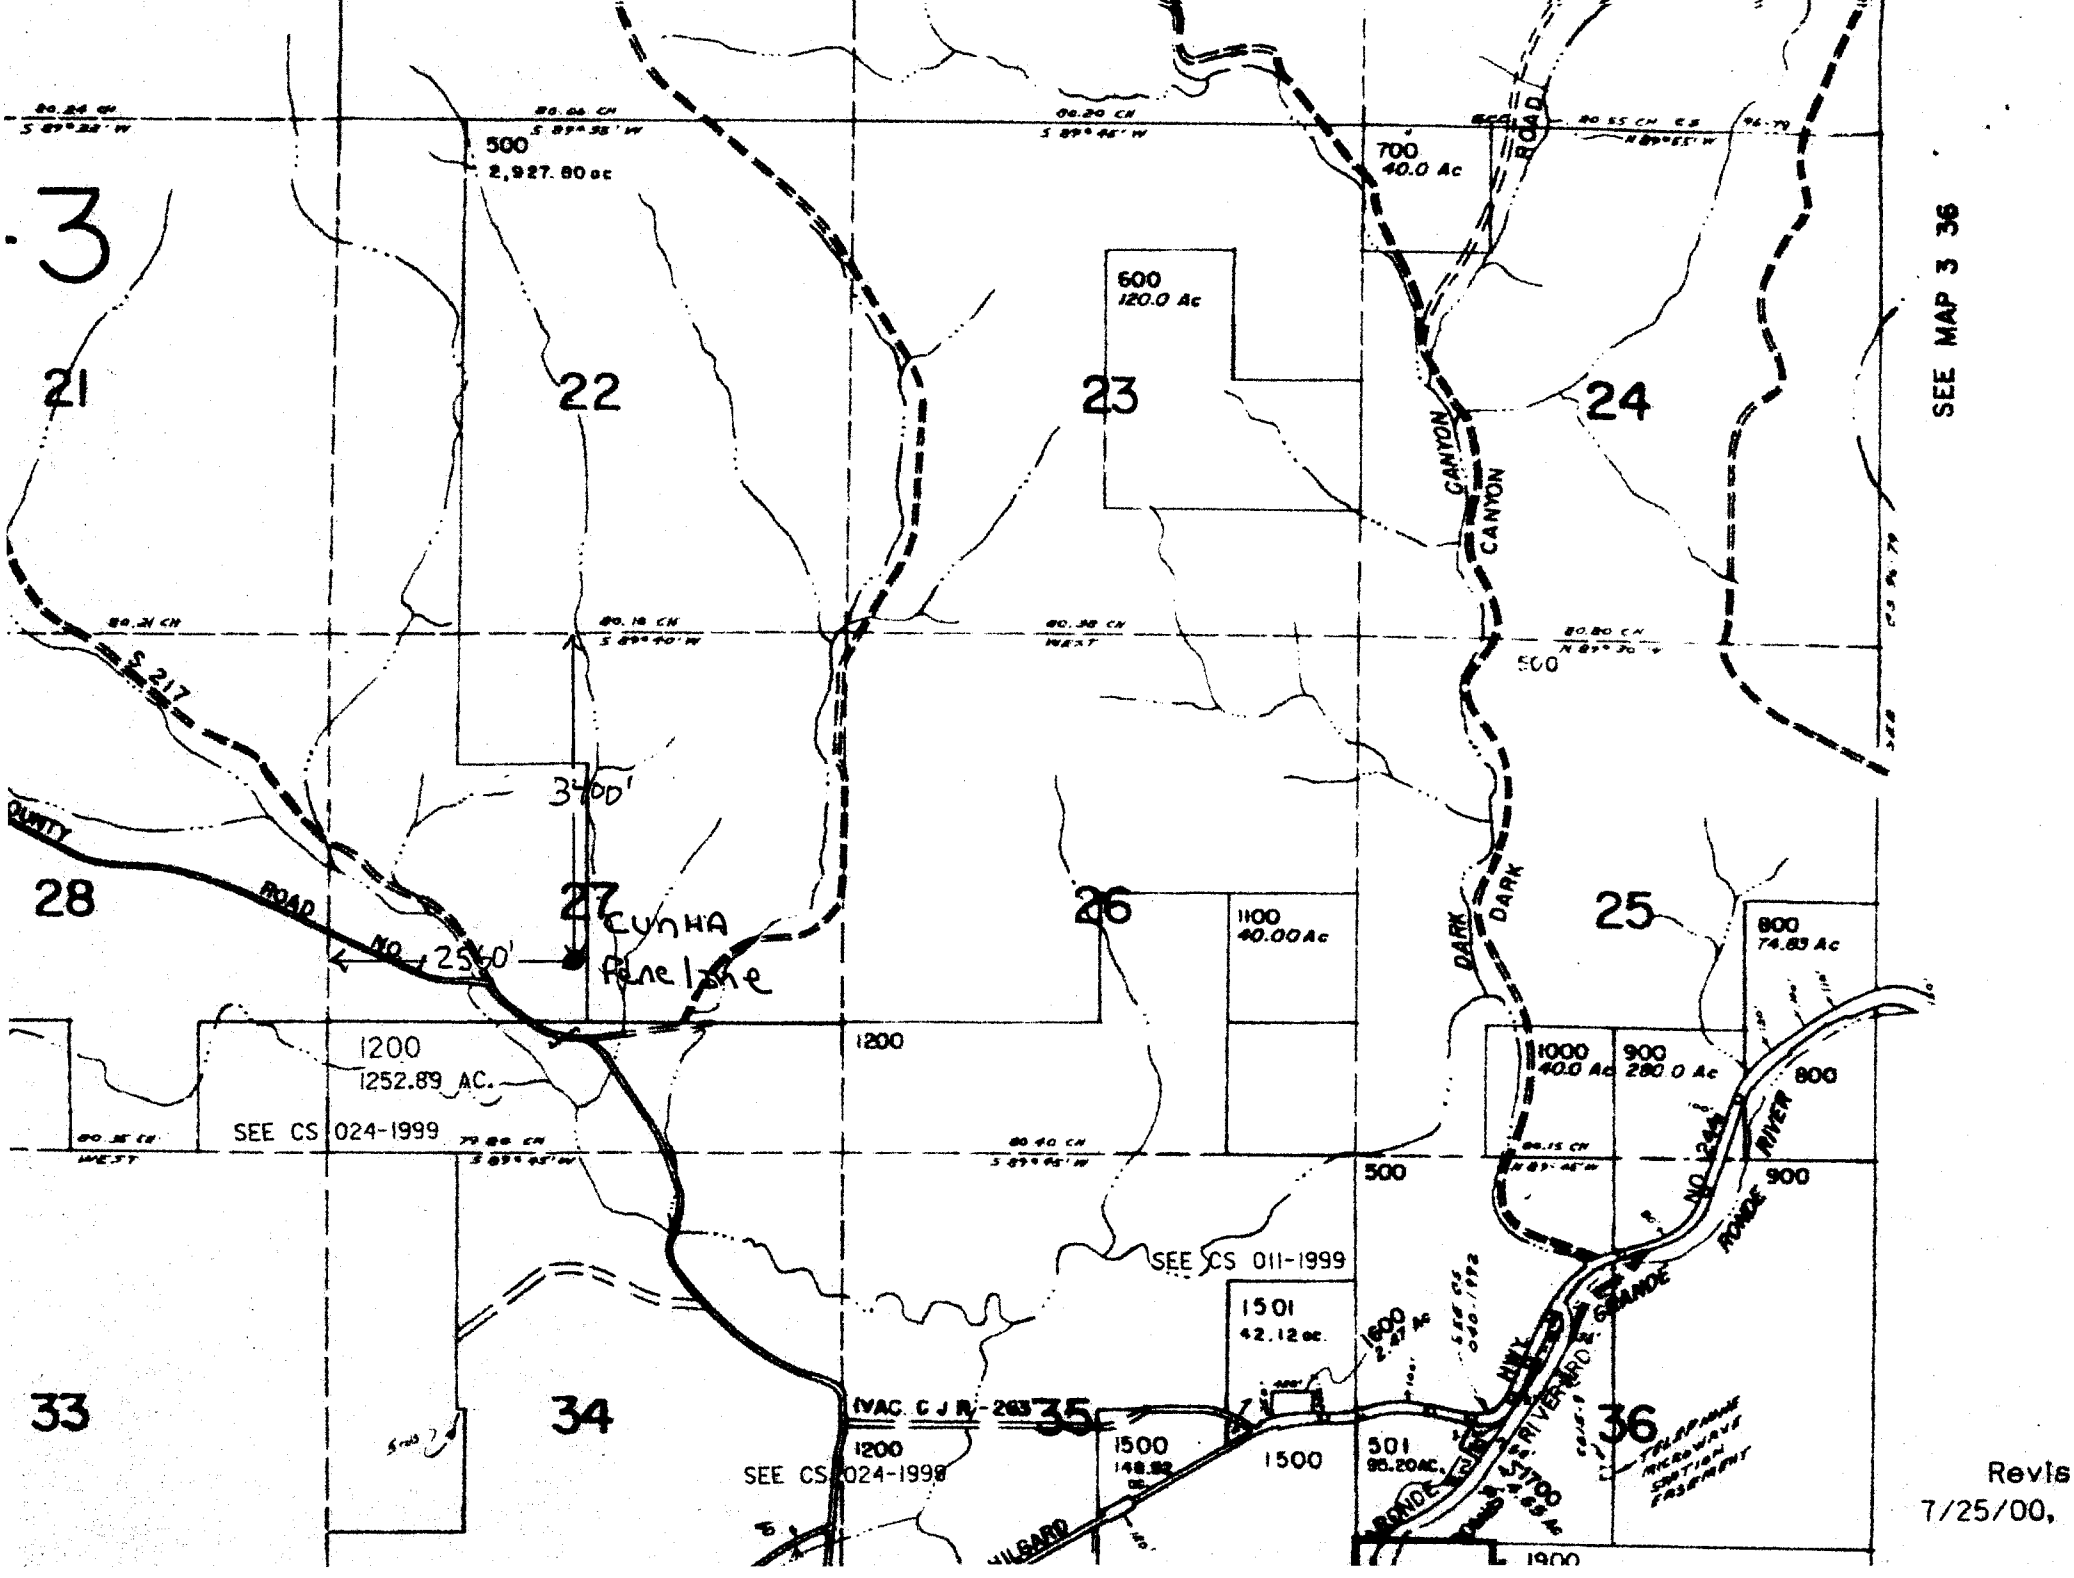
3
21
22
23
24
25
26
27
28
33
34
35
36
500
2,927.80 ac
600
120.0 Ac
700
40.0 Ac
1100
40.00 Ac
800
74.83 Ac
1000
40.0 Ac
900
280.0 Ac
1200
1252.89 AC.
SEE CS 024-1999
SEE CS 011-1999
1501
42.12 ac.
1500
501
95.20 AC.
1200
1500
1900
S 217
ROAD
NO. 2560'
3400'
CUNHA
Pine Lane
CANYON
DARK
RIVER
GRANDE
RONDE
HWY
SEE MAP 3 36
Revis
7/25/00,