


Work copy R-85257  
 T11S R3W R-13429  
 1" = 400'

See Map 11 3W 23

See Map 11 2W 19

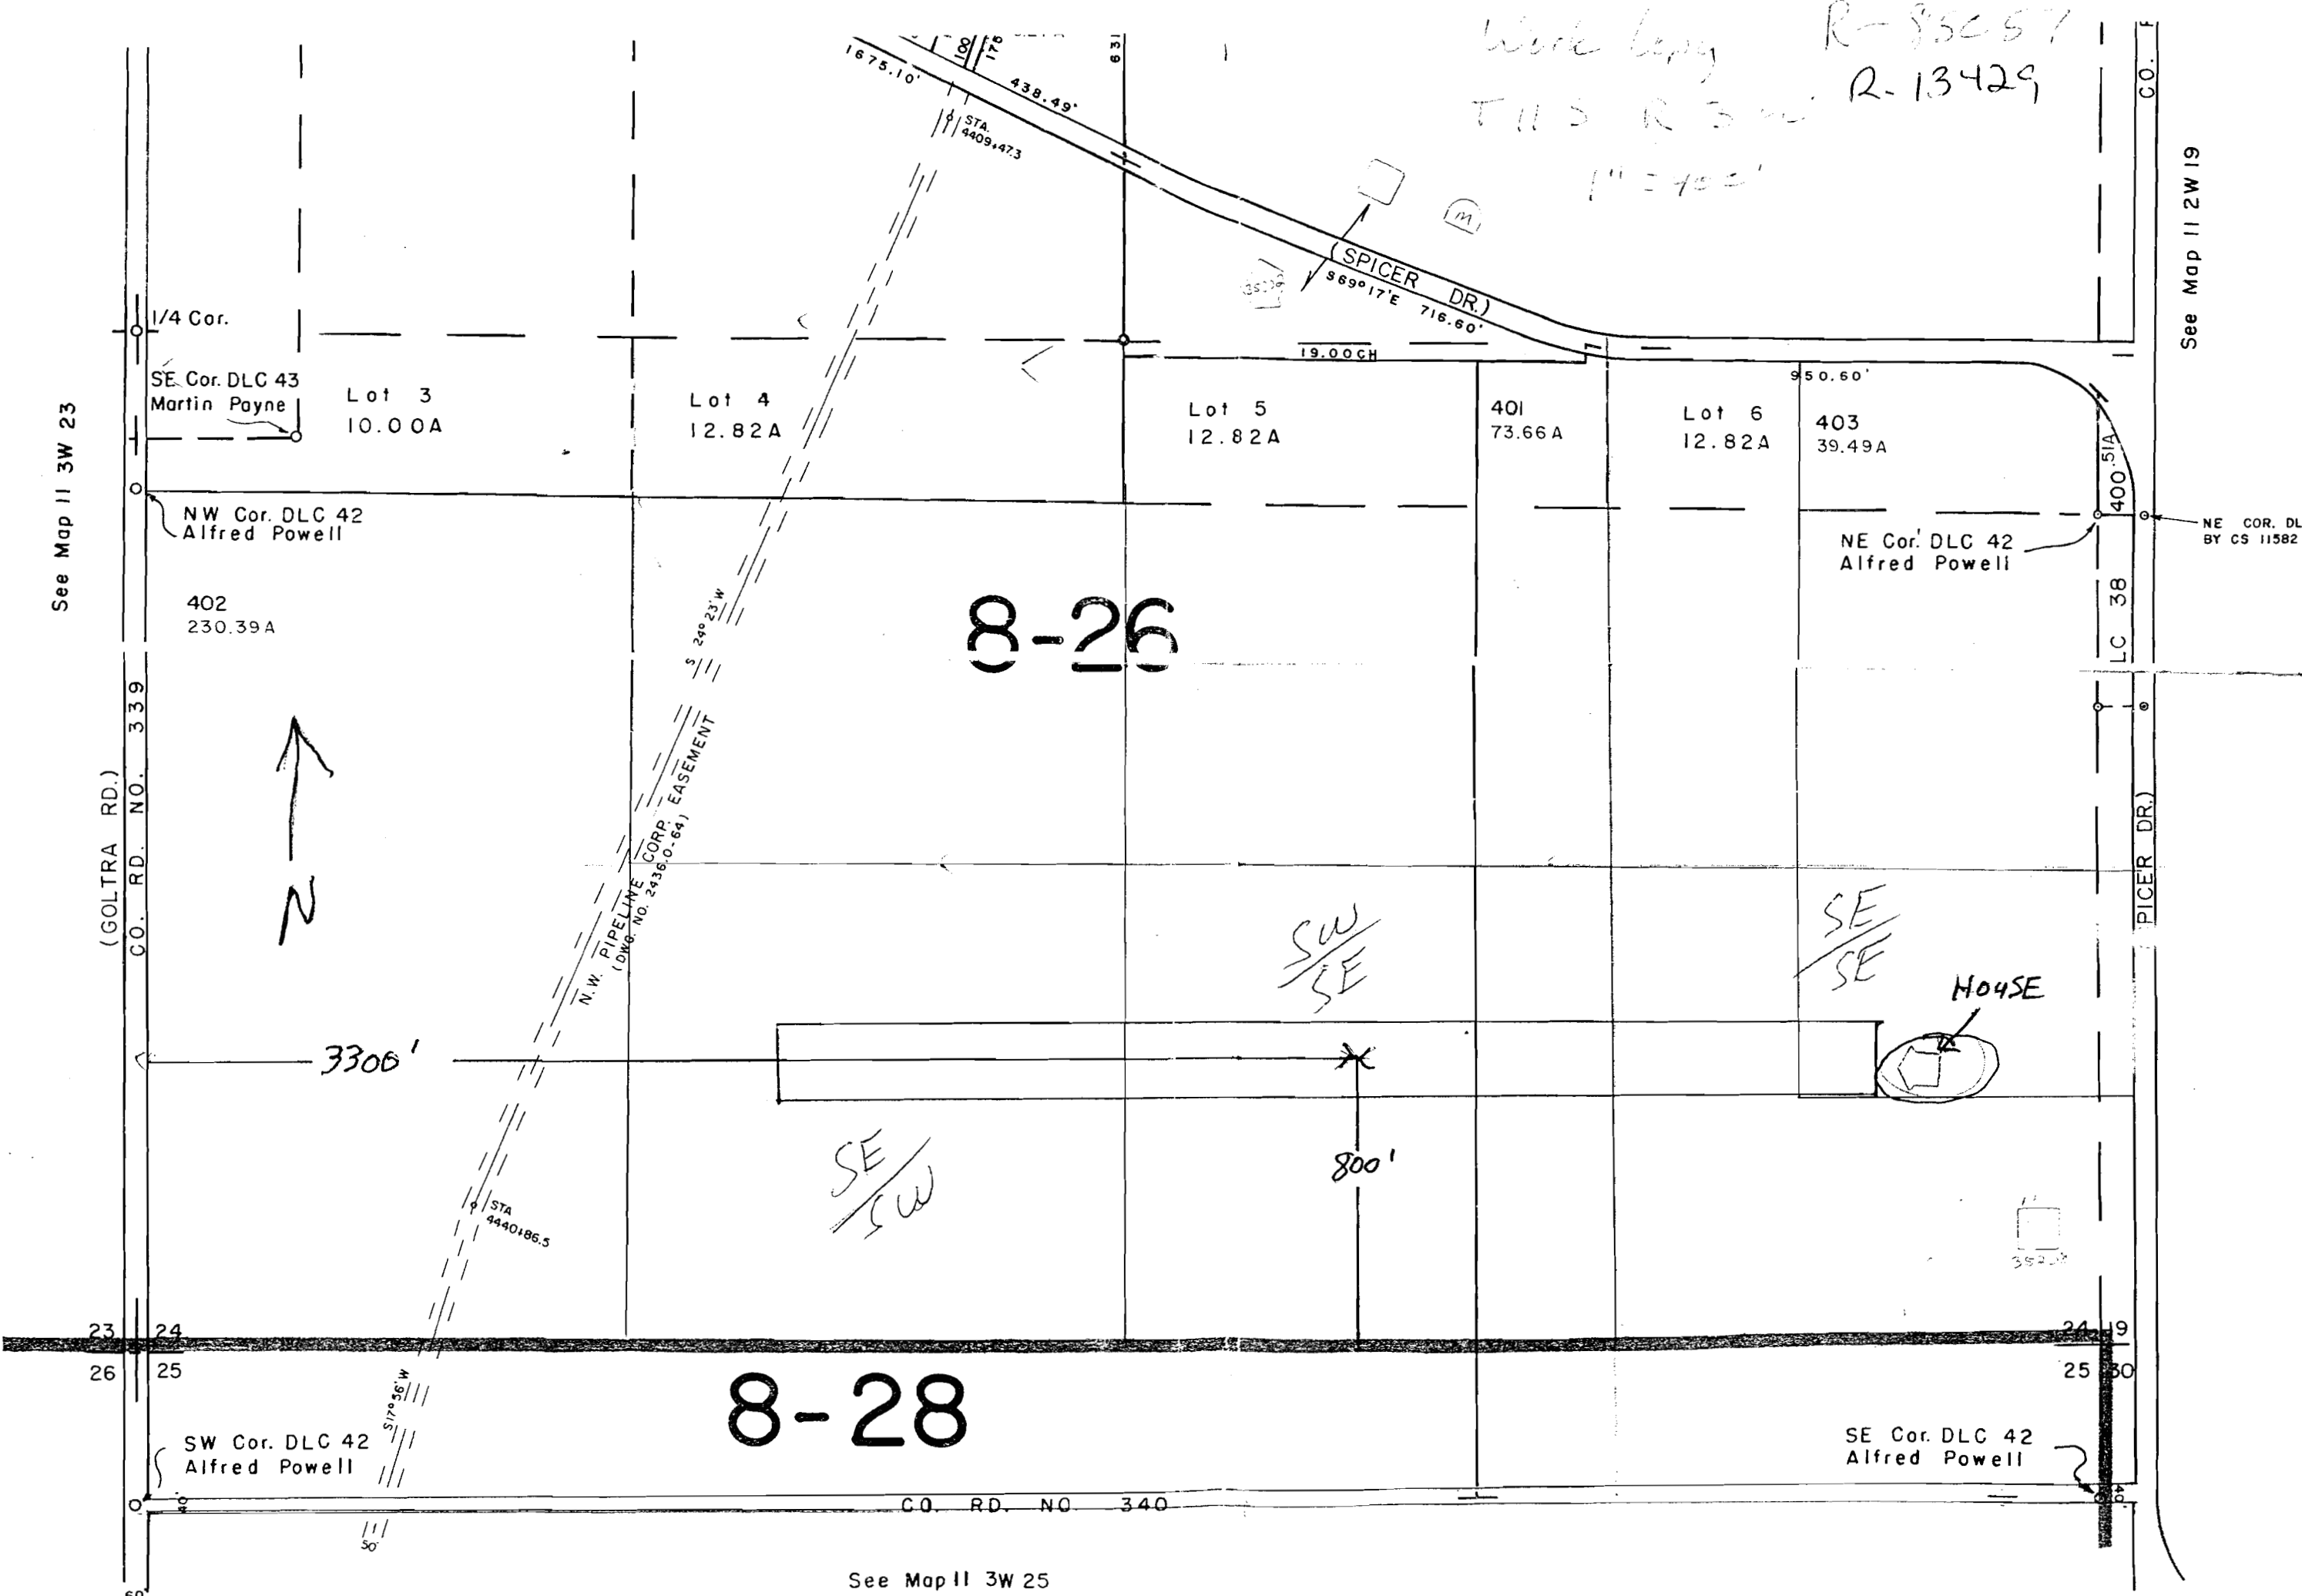

See Map 11 3W 25