


765, R6W, Sect. 35 1" = 800'

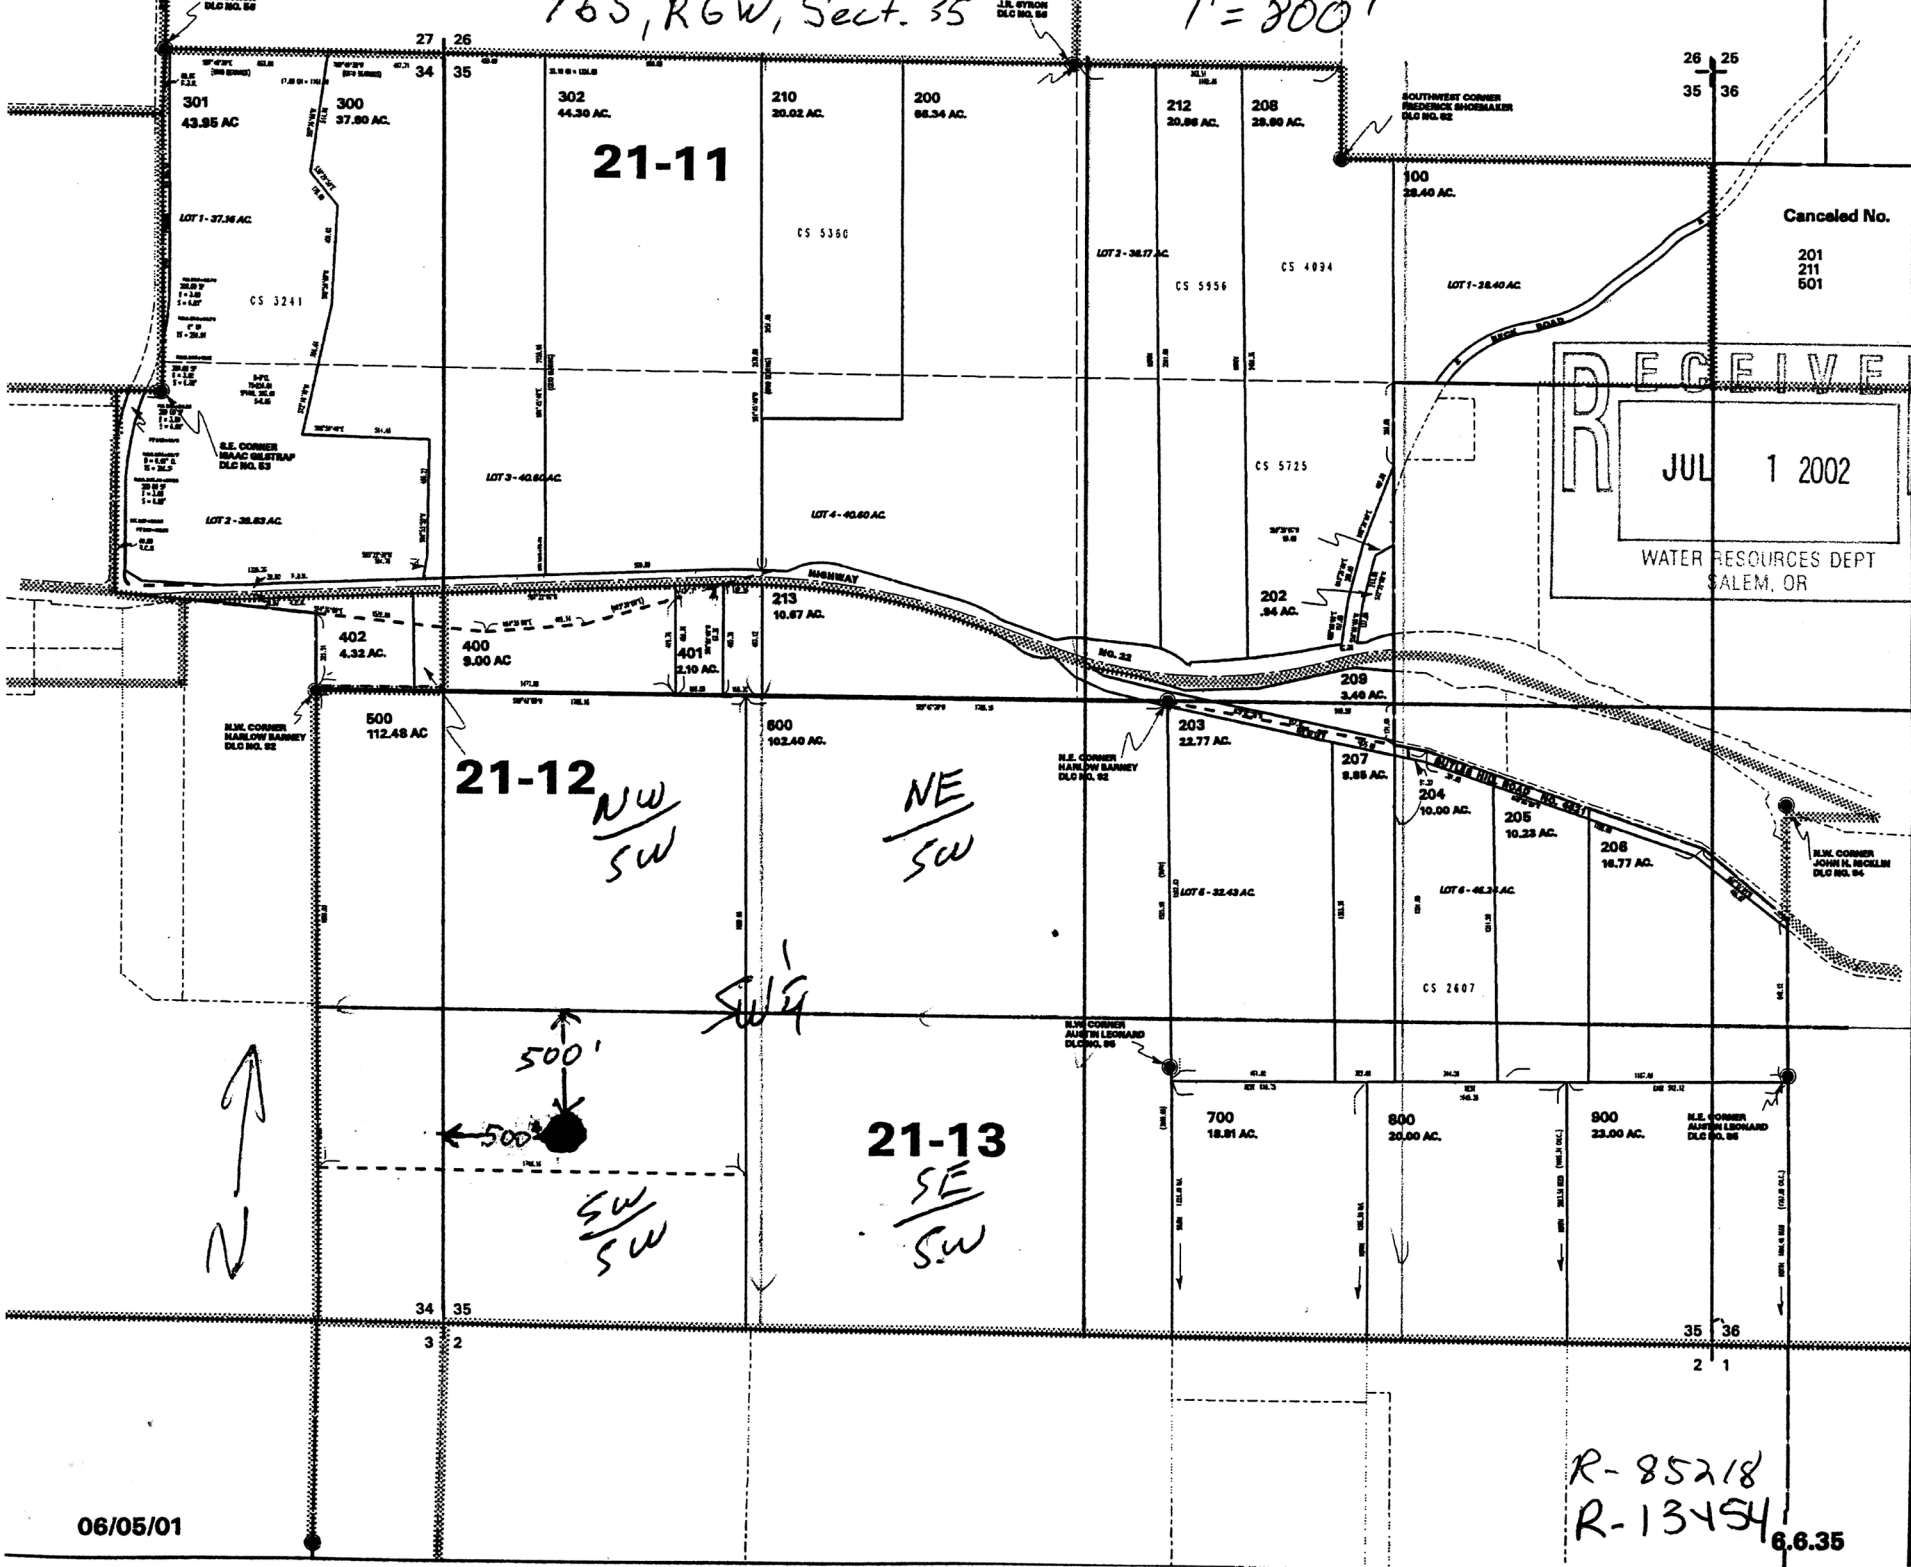

RECEIVED
 JUL 1 2002
 WATER RESOURCES DEPT
 SALEM, OR

R-85218
 R-13454 6.6.35

06/05/01