RECEIVED
JAN 0 2 2002
WATER RESOURCES DEPT.
SALEM, OREGON

T. 11S., R. 20E., W. M.

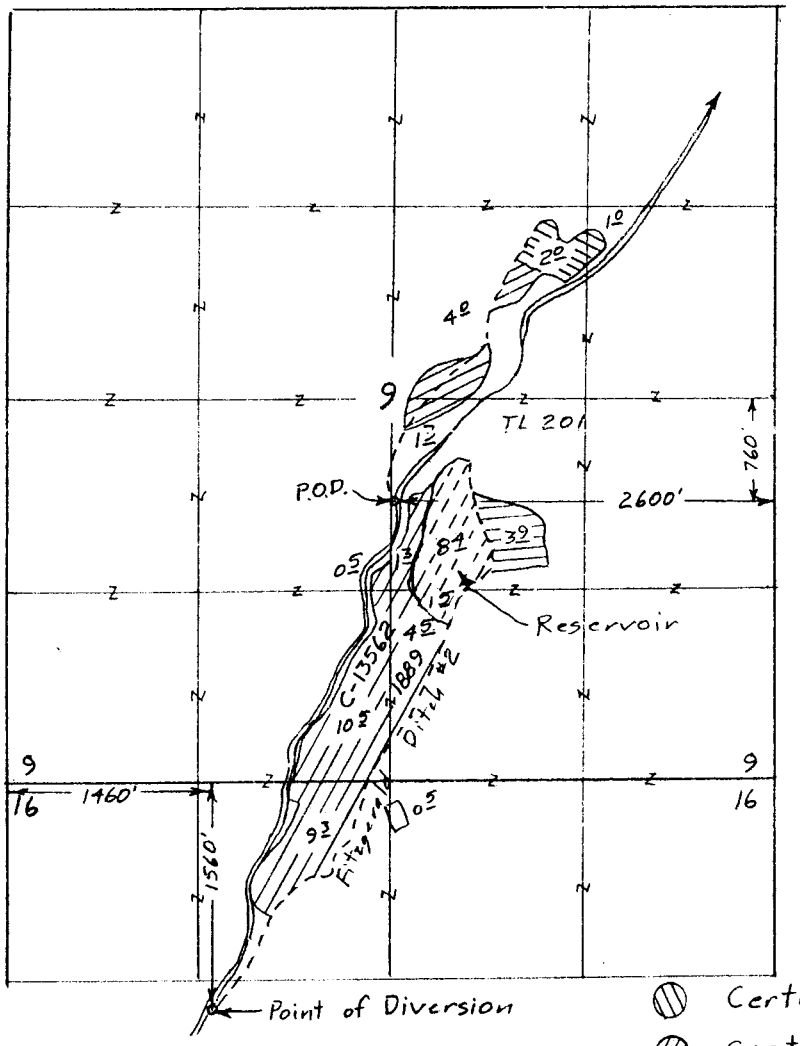

Scale 1" = 1320'

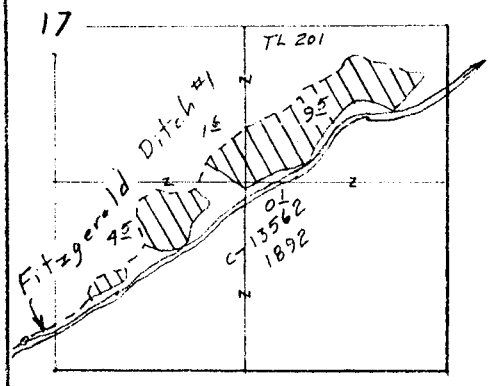

- T-8691 off 9.9 acres (C-13562 1889)
- T-8691 on 3.9 acres
- T-8691 to reservoir maintenance (6 acre equivalent)

- Certificate 13562 (1892) 15 acres
- Certificate 13562 (1889) 36 acres
- T-8238 (1889) 5 acres
- T-8238 (1897) 3 acres

T-8691
R-84668

Transfer Application Map & app # R-84668
Reservoir Application Map Permit # R-13455
for
TERRY & PEGGY LONG

Certified Water Right Examiner #1
Bruce A. Estes
Nov. 19, 1987
STATE OF OREGON

Renewed Dec 31 2003
Amended Dec 29, 2001

This map is for the purpose of locating a water right only and has no intent to provide legal dimensions or the location of property lines.

ESTES SURVEYS, LLC
PO Box 17519
Salem, OR 97305-7519
(503) 585-7593
60382 Arnold Rd
Bend, OR 97702
(541) 382-7391