


FROM COMMON SECTIONS  
29, 30, 31, 32




1650 FT EAST  
2480 FT SOUTH

Scale 1 in = 400 ft

SEE MAP  
1 S 3 29

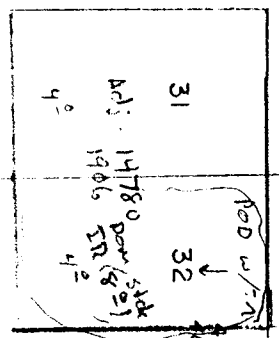

15-6

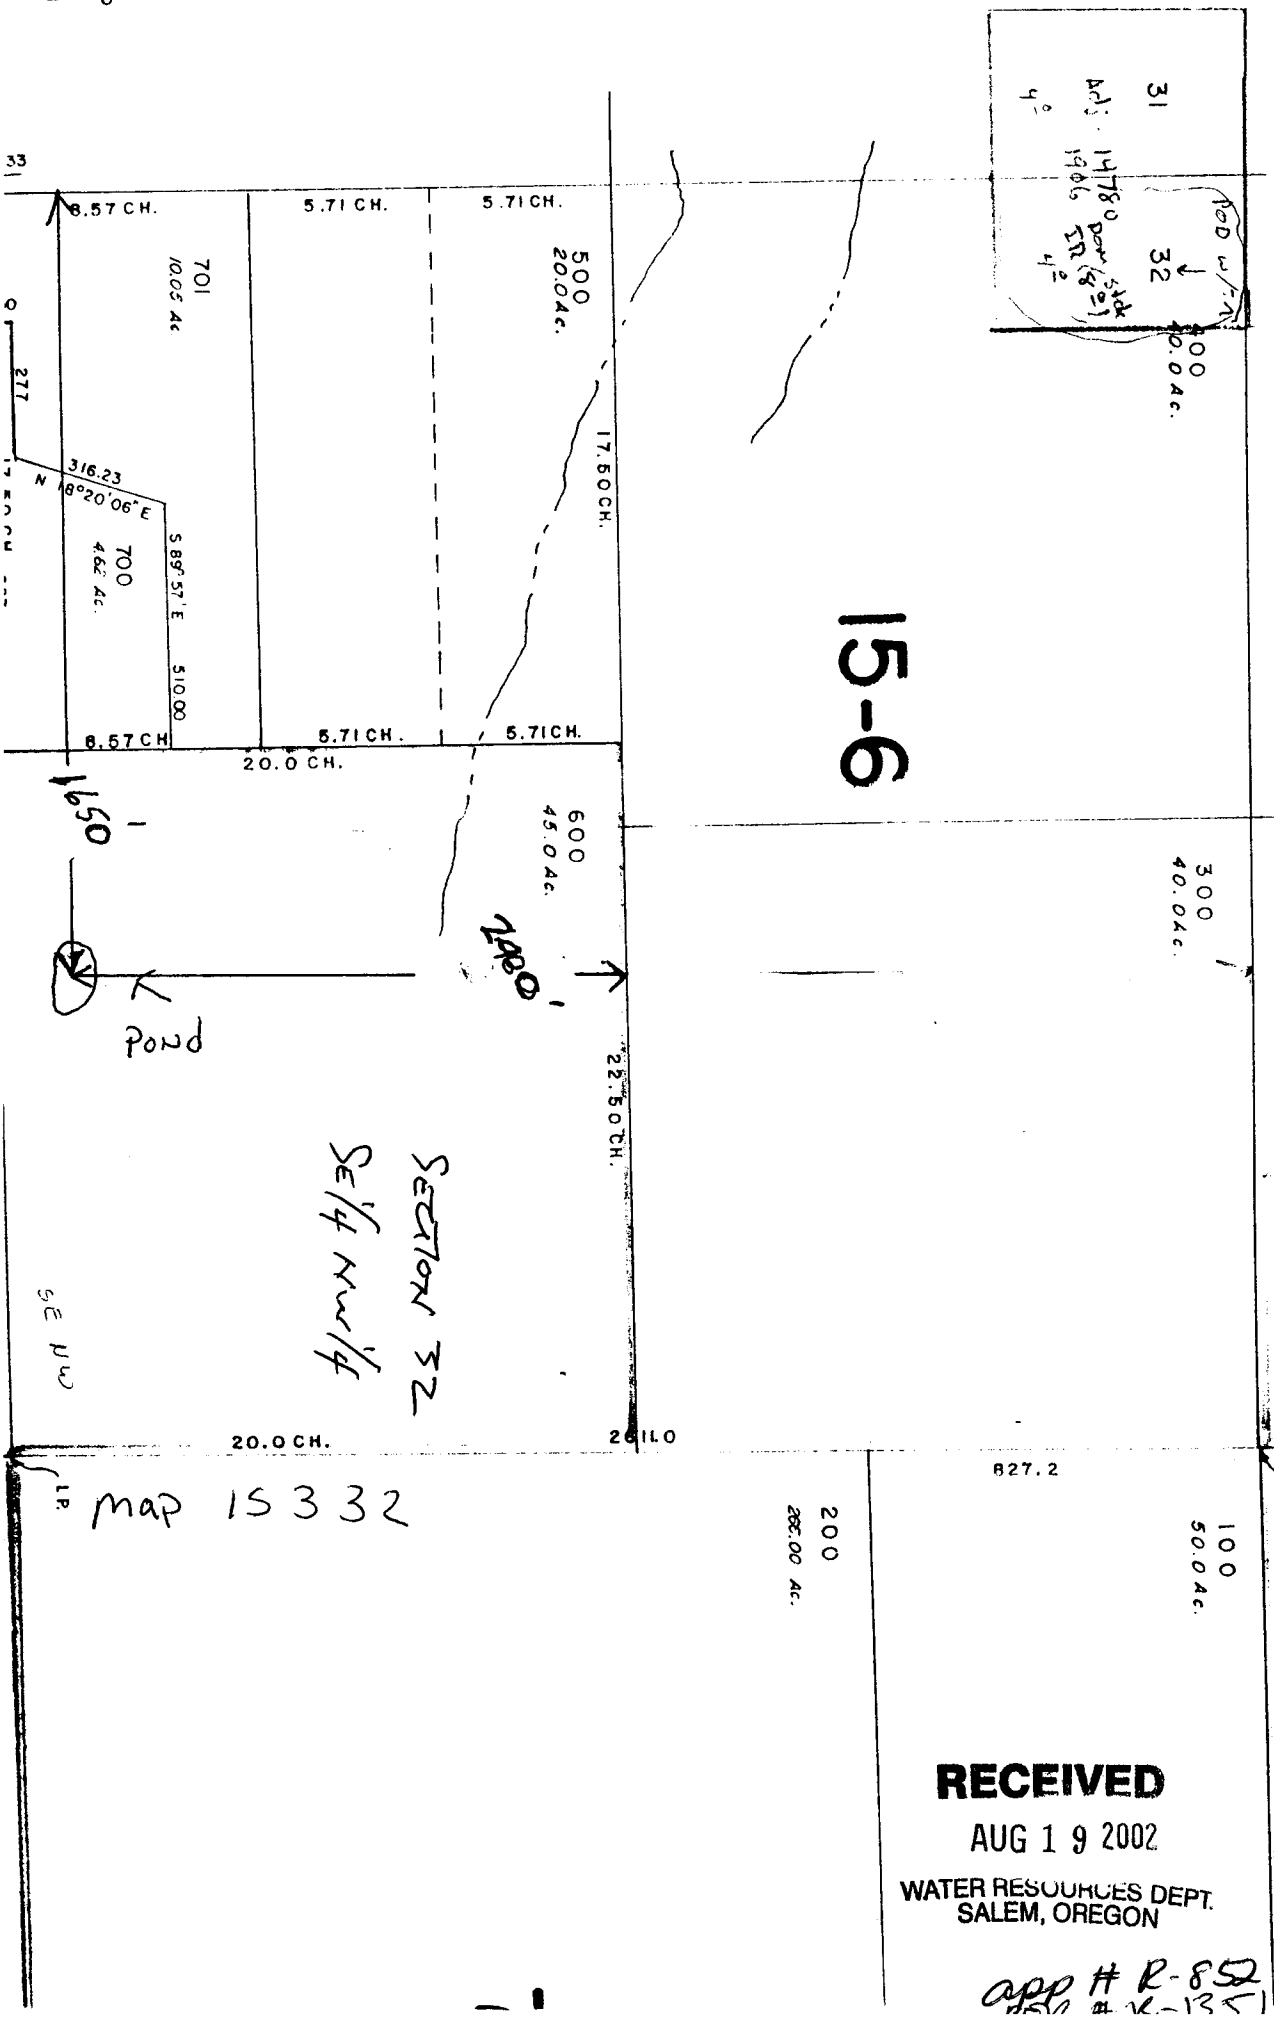

MAP  
31

map 15332

SECTION 32  
SE 1/4 NW 1/4

RECEIVED

AUG 19 2002

WATER RESOURCES DEPT.  
SALEM, OREGON

app # R-85  
# 12-135

N 89° 41' E