

Township 35 South

Township 36 South

POD # 1

Table Rock Canal POD of Record

420' East

1810' South

From the NW Cor. Section 6

2

1

1

6

Domestic POD is located in Tax Lot 36-2W-12-300

Lake is located in Tax Lots

36-2W-12-300

36-2W-12-301

36-2W-13-301

Range 2 West

Range 1 West

Rogue River

*Add'l to  
R-84686  
4-16-02  
KJ*

**Application No.**  
**Permit No.**

*AS 4705*

2

1

11

12

12

7

Table Rock Canal

POD # 2

1290' North

1360' West

Fm SE Cor. Sec. 12

DLC 37

House Location

DLC 38

11

12

14

13

DLC 41

TL 301

TL 300

VanWey Lake

**RECEIVED**

MAR 26 2001

WATER RESOURCES DEPT.  
SALEM, OREGON



Scale 1" = 1320'

Dam Location

522' South

2903' East

Fm the SE Cor. Sec. 12

Domestic POD


207' North

2684' East

Fm the SE Cor. Sec. 12

Township 36 South, Range 2 West, W.M.

Sections 12 and 13

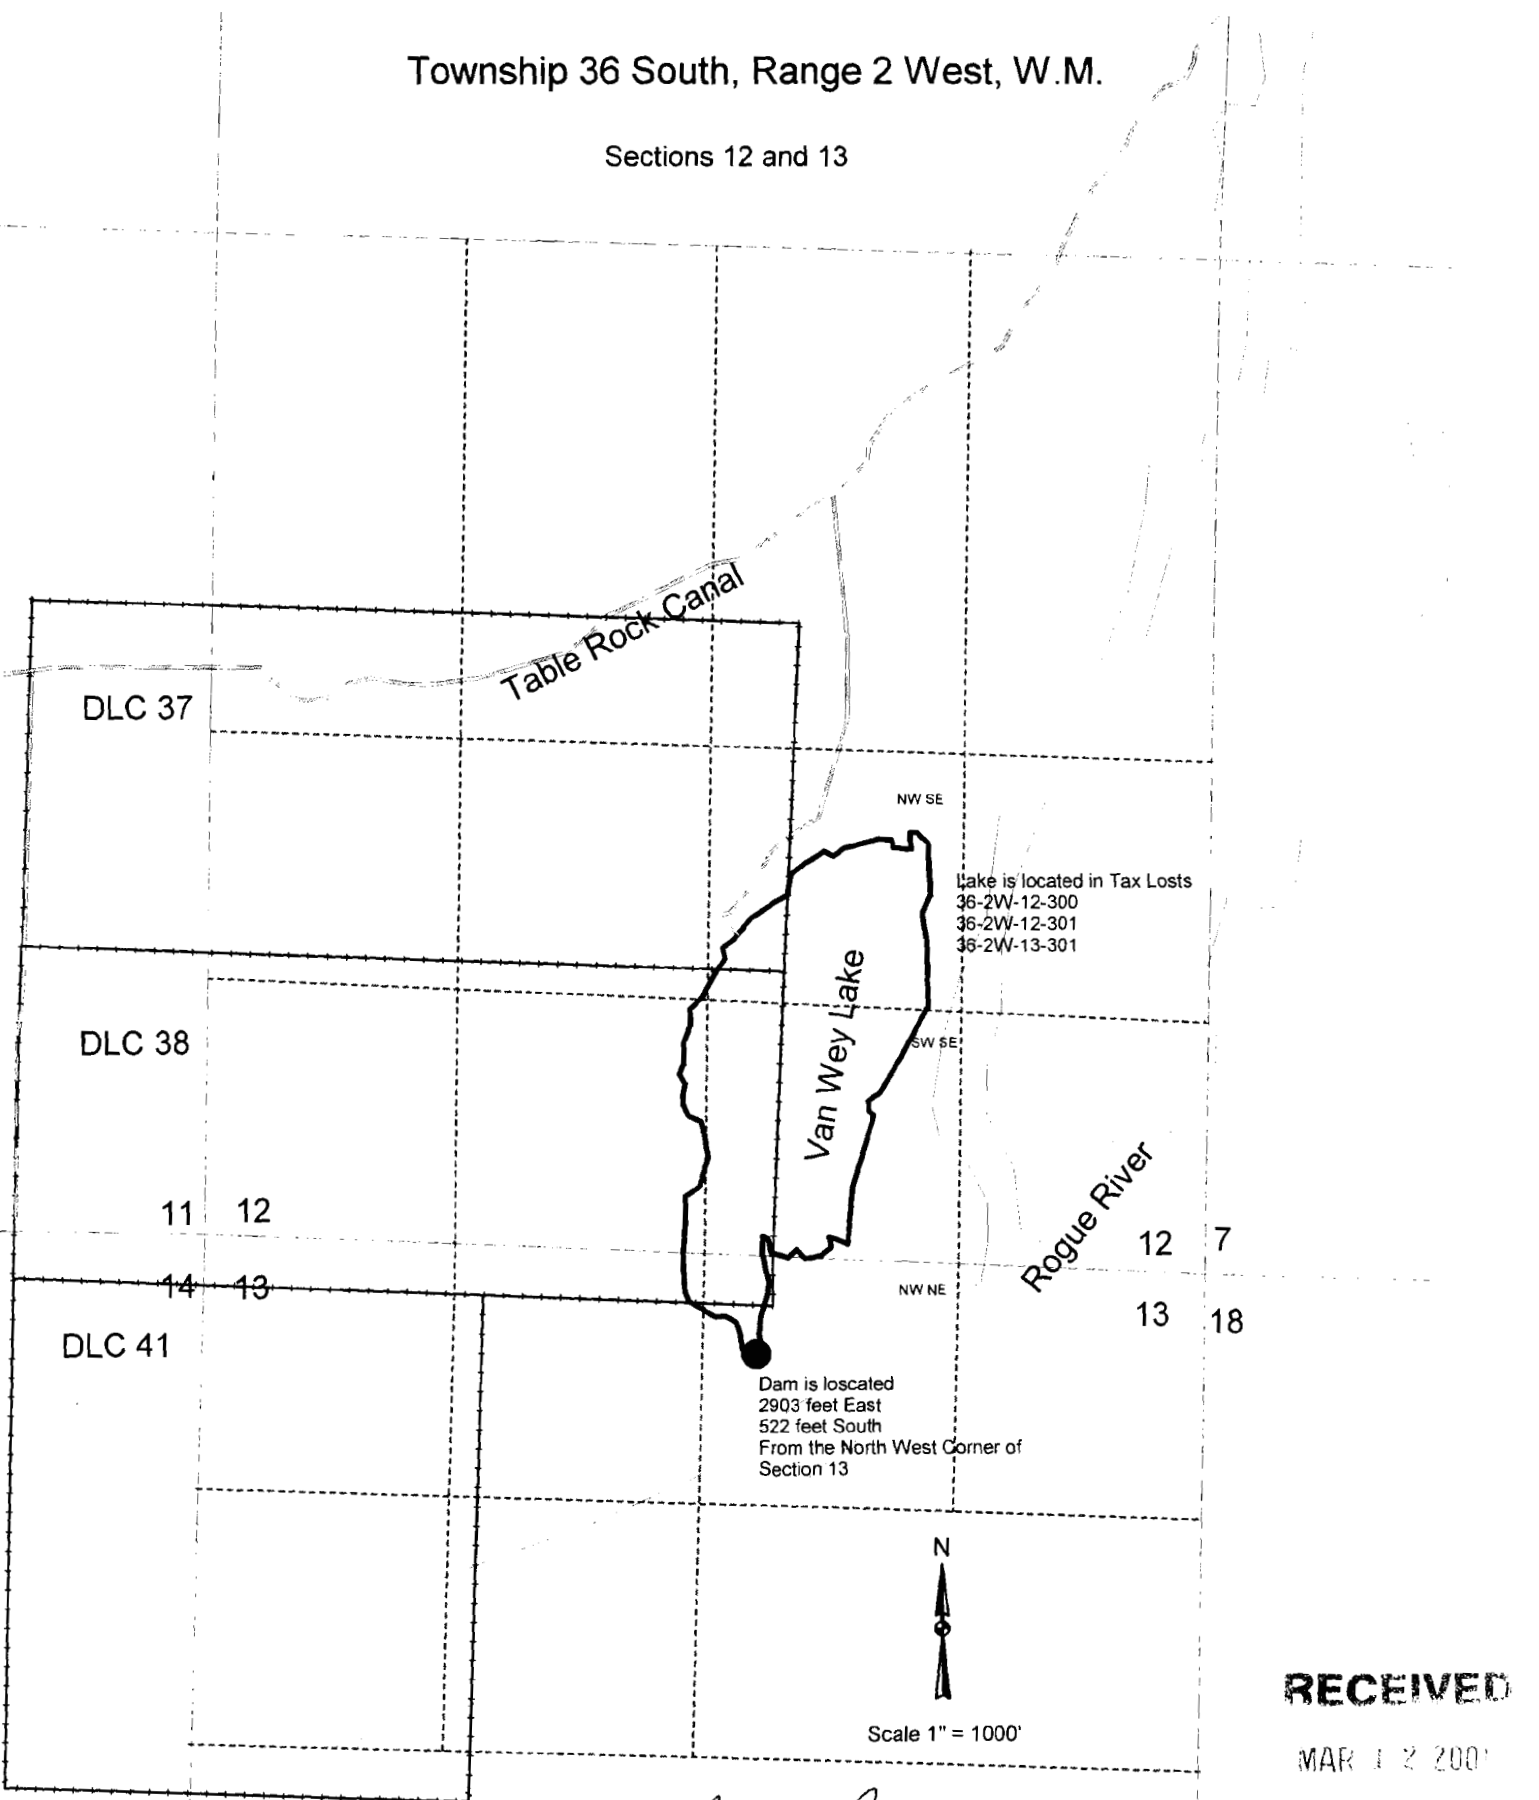

App # R-84686  
Permit # R-13525

Rogue R & Mill Ck.

POD # 1  
Table Rock Canal POD  
of Record  
420' East  
1810' South  
From the NW Cor. Sec 6  
T 36 S, R 1 W, W.M.

2 1

1 6

11 12

12 7

Map for application  
R 84686  
Located in Sec. 12 & 13  
T 36 S, R 2 W, W.M.

DLC 37

NWSE

NESE

TL 300

POD # 2  
1290' North  
1360' West  
Fm SE Cor. Sec. 12

DLC 38

SESW

SWSE

SESE

TL 301

Van Wey Lake

11 12

12 7

14 13

NENW

NWNE

TL 301

13 18

App #  
R. 84686  
Permit #  
R. 13525

DLC 41

Rogue River

RECEIVED

APR 24 2002

WATER RESOURCES DEPT.  
SALEM, OREGON

Scale 1" = 1000'