

Application No. ~~R-84784~~ R-85488  
Permit No. R-13551


RECEIVED

JUN 18 2001

WATER RESOURCES DEPT.  
SALEM, OREGON

APPLICATION MAP  
IN THE NAME OF UNION PACIFIC RAILROAD COMPANY

SECTIONS 13, 14, and 24 T1S, R1E, W.M.

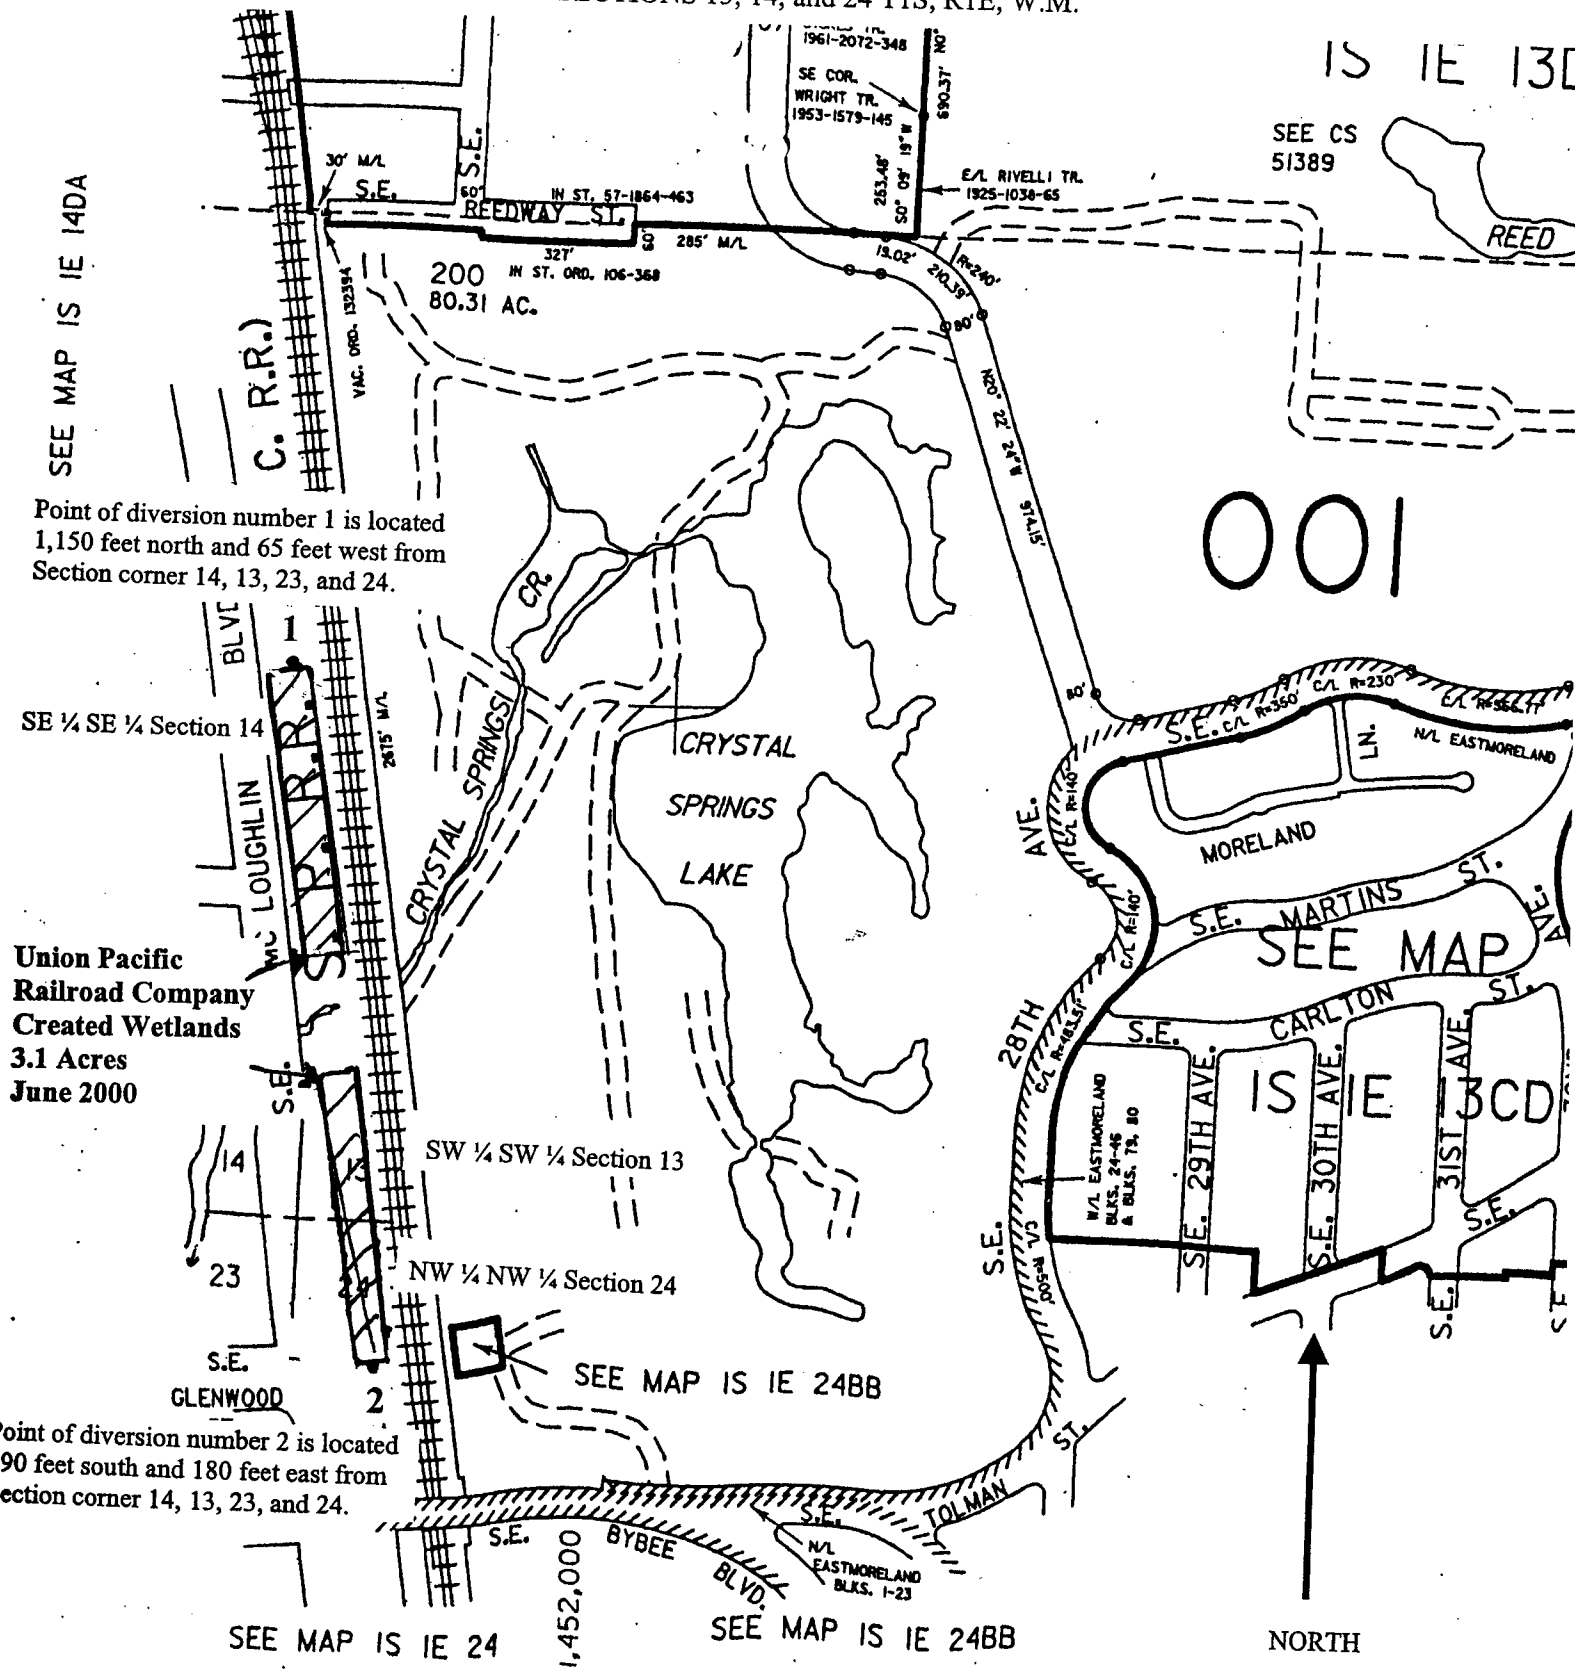

SEE MAP IS IE 14DA

IS IE 13C

SEE CS  
51389

REED

001

SEE MAP

IS IE 3CD

SEE MAP IS IE 24BB

SEE MAP IS IE 24

SEE MAP IS IE 24BB

NORTH