


RECEIVED

DEC 19 2002

WATER RESOURCES DEPT.
SALEM, OREGON

T. 35. R. 1E. SECTION 25 W.M.

POND LOCATION:
300 FT SOUTH AND
1800 FT EAST FROM
THE W 1/4 CORNER

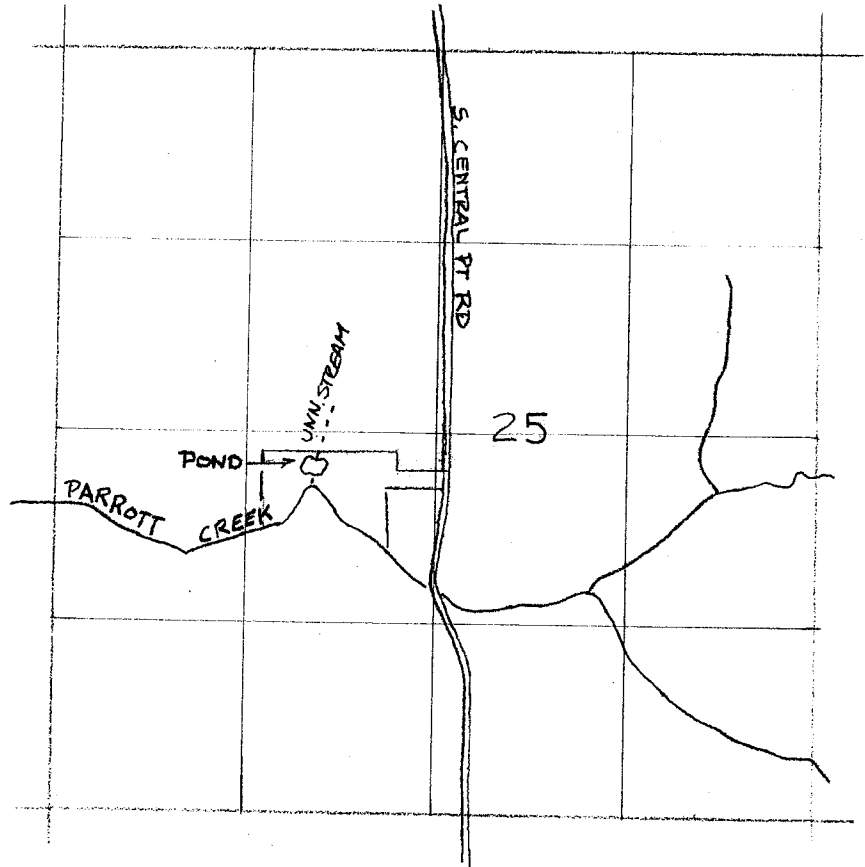

SCALE 1:12,000
1" = 1320'
1" = ~~1000~~ ft.

POND DMS: 045° 16' 50.8" N,
122° 37' 55.8" W

App # R-85386
Permit # R-13558

app # R-85386
Permit #