

1" = 200'

SEE 3 2 14


app # R-85352  
 Perm # HWM # 11101

AS PER CONVERSATION  
 WITH ROGER WRIGHT  
 A.M. 11/12/02  
 HE WILL ASSIST IN  
 LOCATING QUADRANT

**RECEIVED**

NOV 25 2002

WATER RESOURCES DEPT.  
 SALEM, OREGON

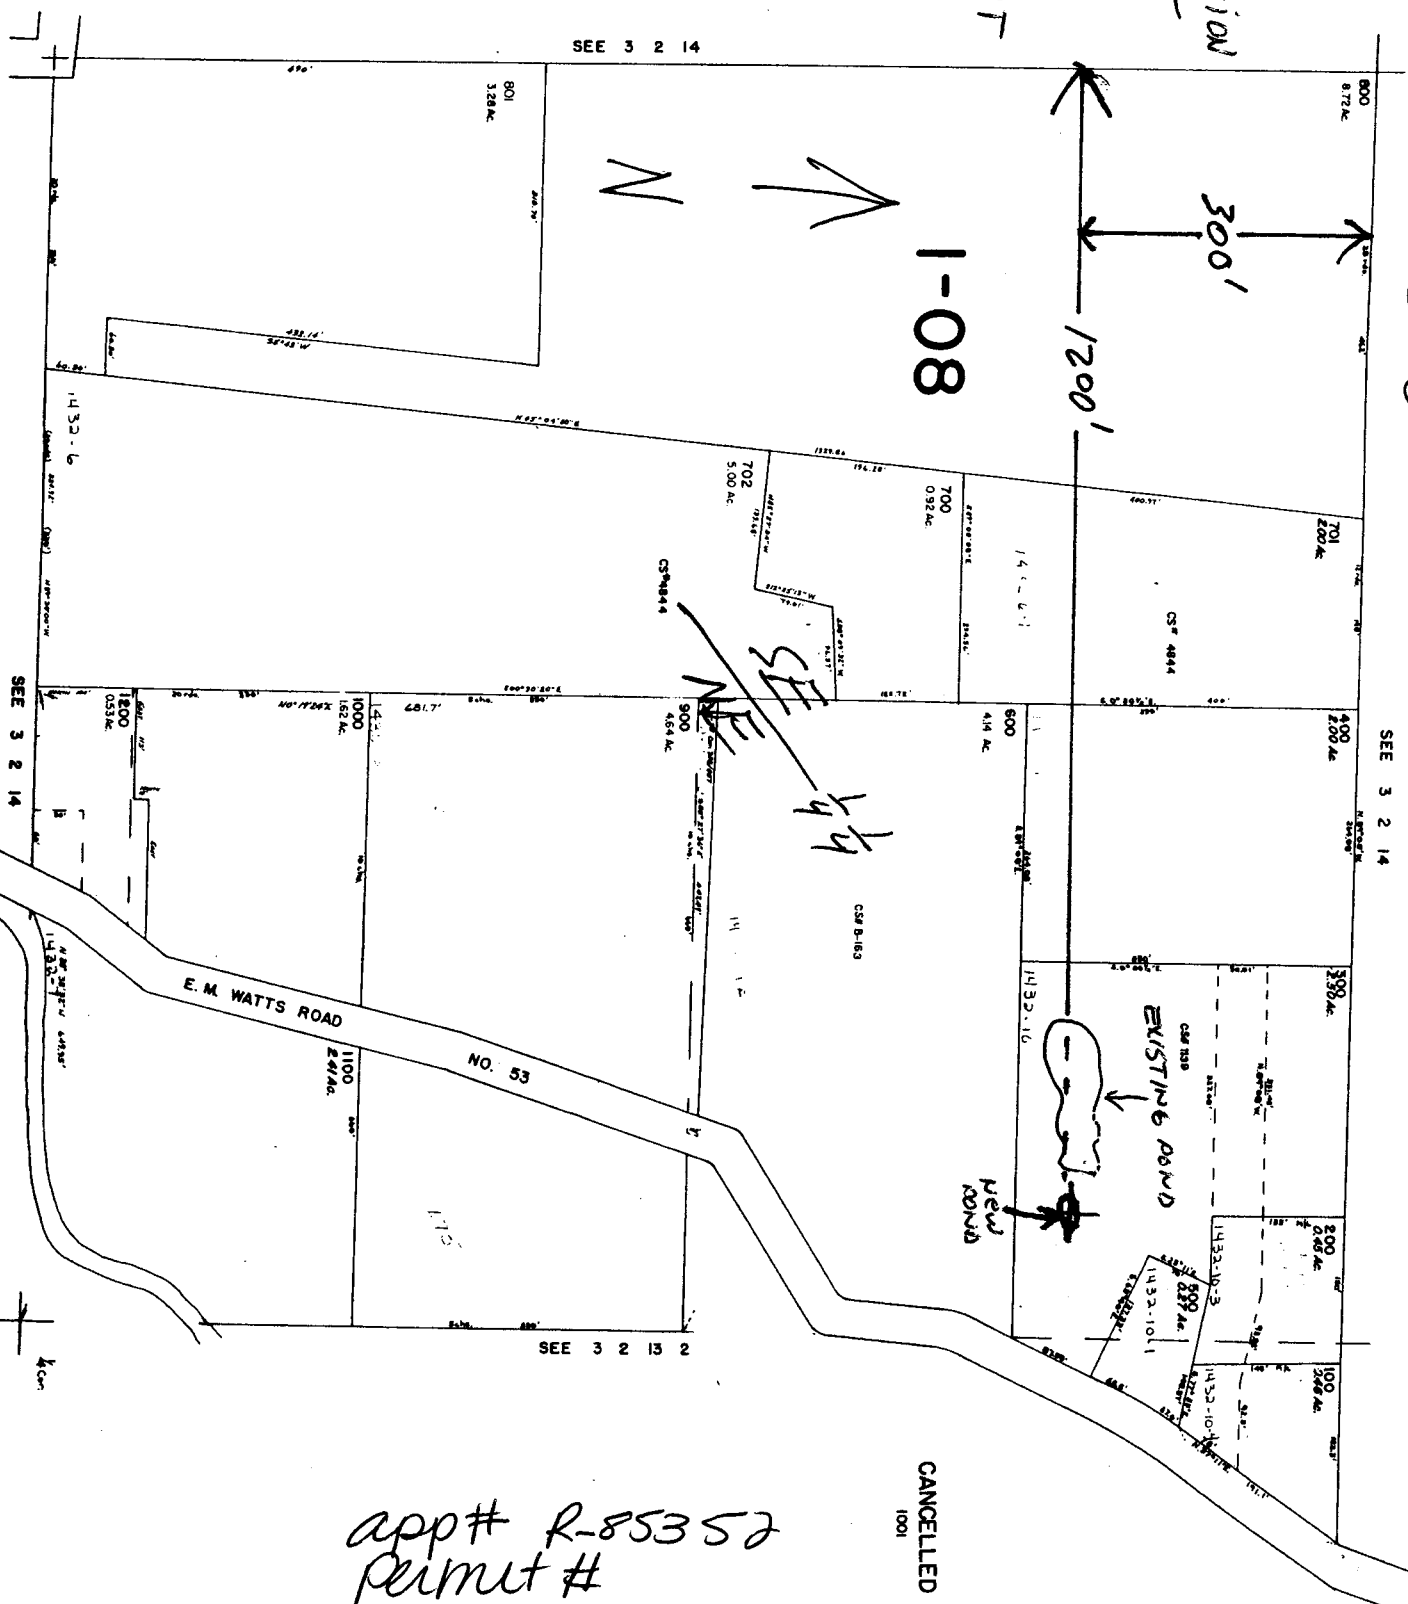

CANCELLED  
 1001

app # R-85352  
 Permit #