

C

SECTION 21 T.
JOSEPHINE


T 37S. R 5W. W.M.
SECTION 21

Map was prepared for
general purpose only.

1" = 400'

SEE MA

POND LOC. 600' S AND 210' E FROM NW 1/4 COR
SEC 21 T. 37S. R 5W. W.M.

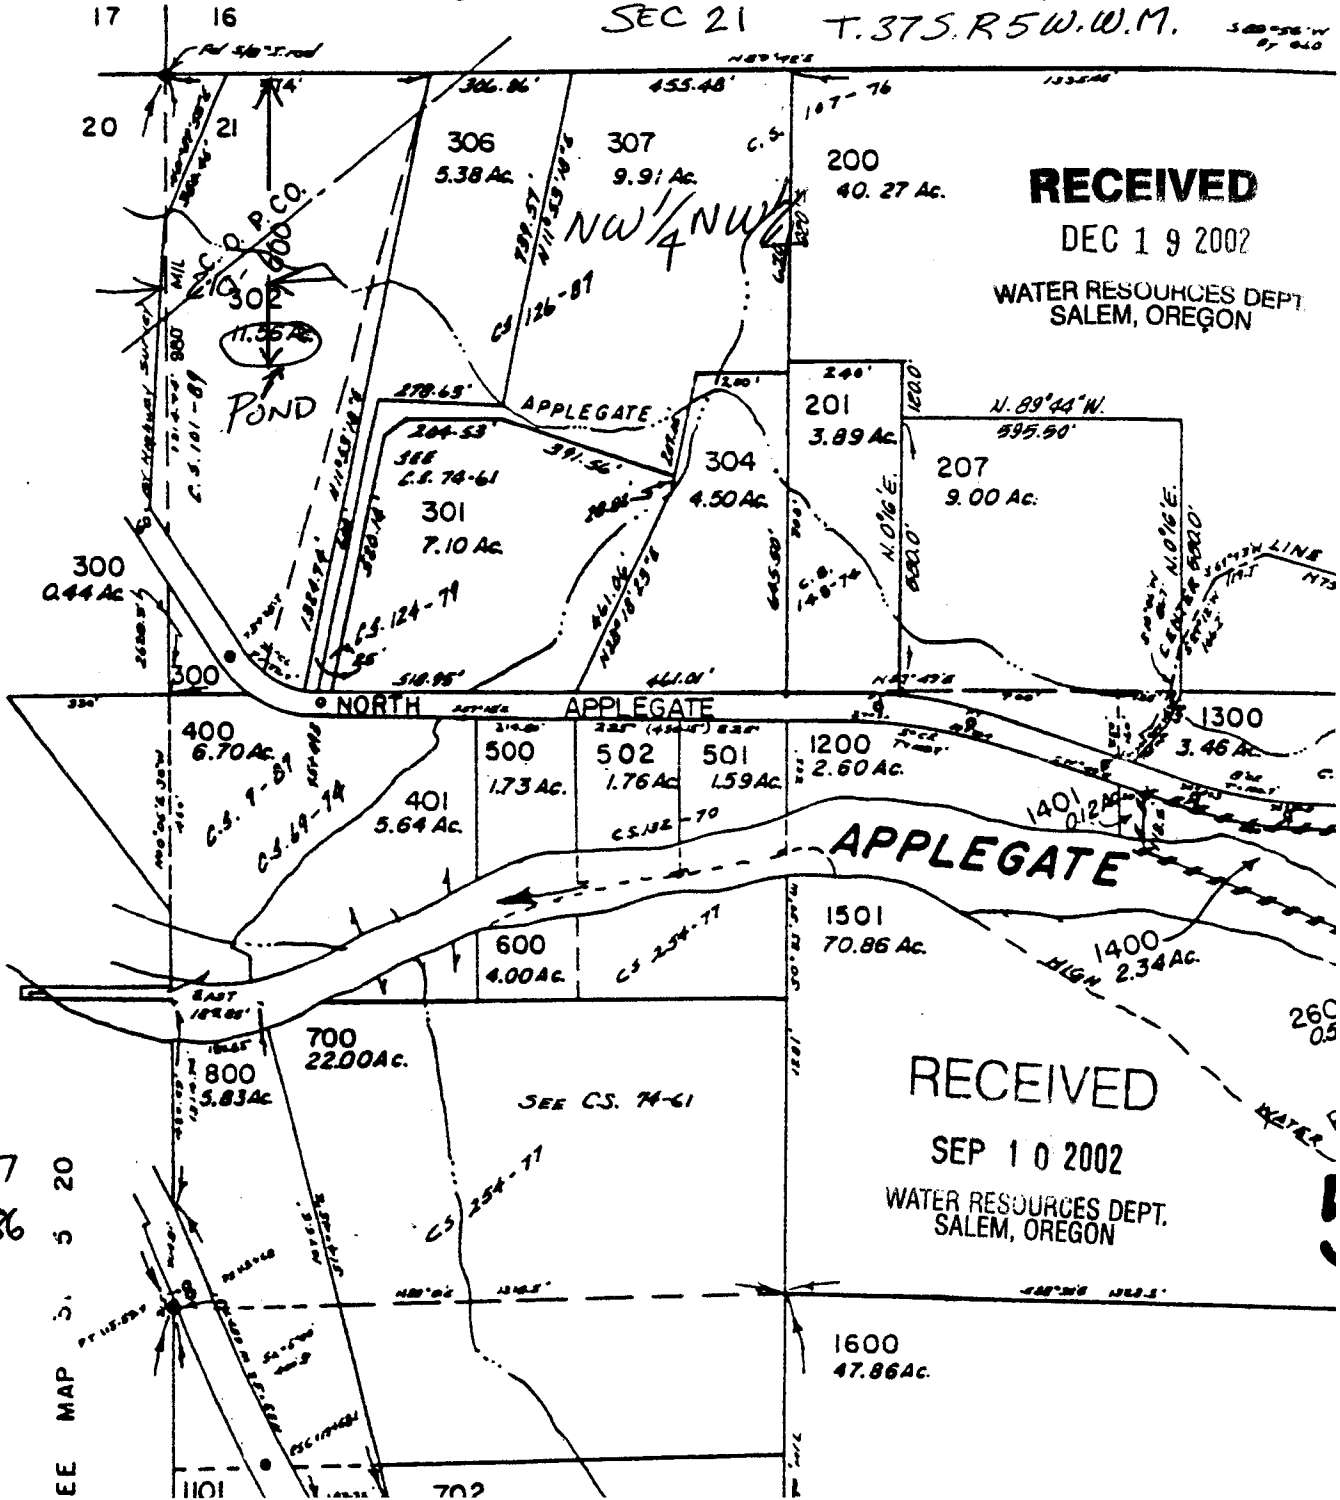

APP R-85387
PER R-13586

EE MAP 5. 5 20

RECEIVED
SEP 10 2002
WATER RESOURCES DEPT.
SALEM, OREGON

RECEIVED
DEC 19 2002
WATER RESOURCES DEPT.
SALEM, OREGON