

RECEIVED


SEP 4 1997

WATER RESOURCES DEPT.  
REGISTRATION

# T. 5 N., R. 36 E., W.M.

WEST ALT POND  
LOCATED FROM WEST 1/4 CORNER  
SECTION 19, 875 FT NORTH &  
250 FT EAST

EAST ALT. POND

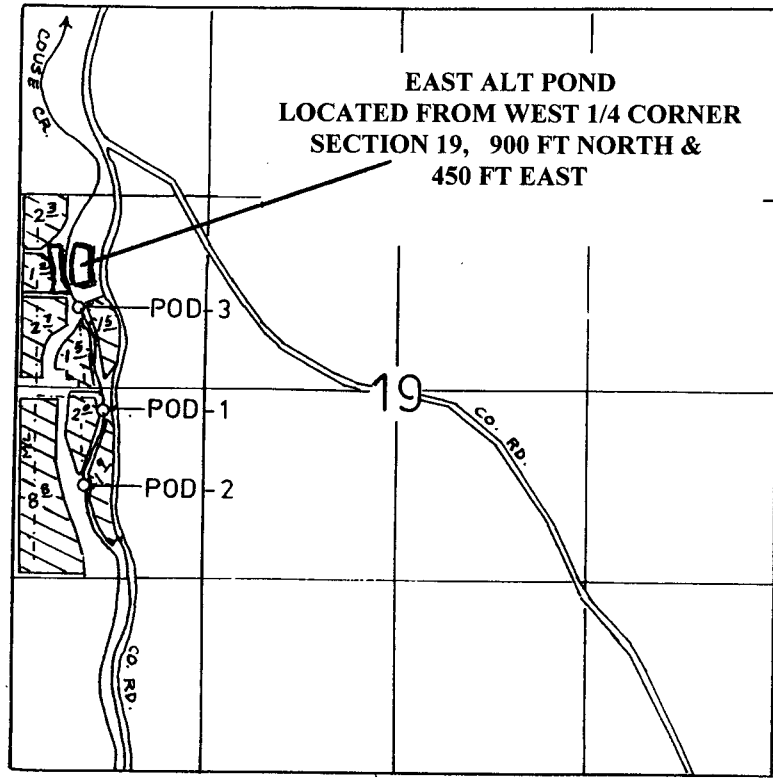

EAST ALT POND  
LOCATED FROM WEST 1/4 CORNER  
SECTION 19, 900 FT NORTH &  
450 FT EAST



1" = 1320'

POD 1 - 150' S. & 610' E.  
POD 2 - 660' S. & 500' E. ALL FROM THE W 1/4 COR. SEC. 19  
POD 3 - 550' N. & 430' E.

App # R-85434  
Permit # R-13590

## FINAL PROOF SURVEY UNDER

Application No. 69183 Permit No. 50170  
IN NAME OF

MICHAEL B. BANKS AND MARIANNE ALDERSON

Surveyed April 29, 1994, by J. Miller