



4 SOUTH RANGE 12 EAST

Scale: 1" = 1320' feet

POND

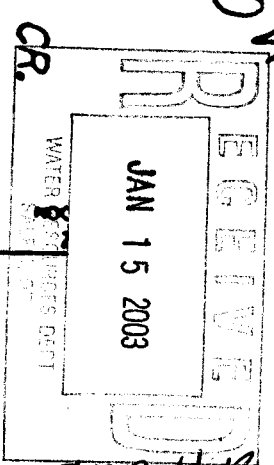

app # R-85416
Permit #

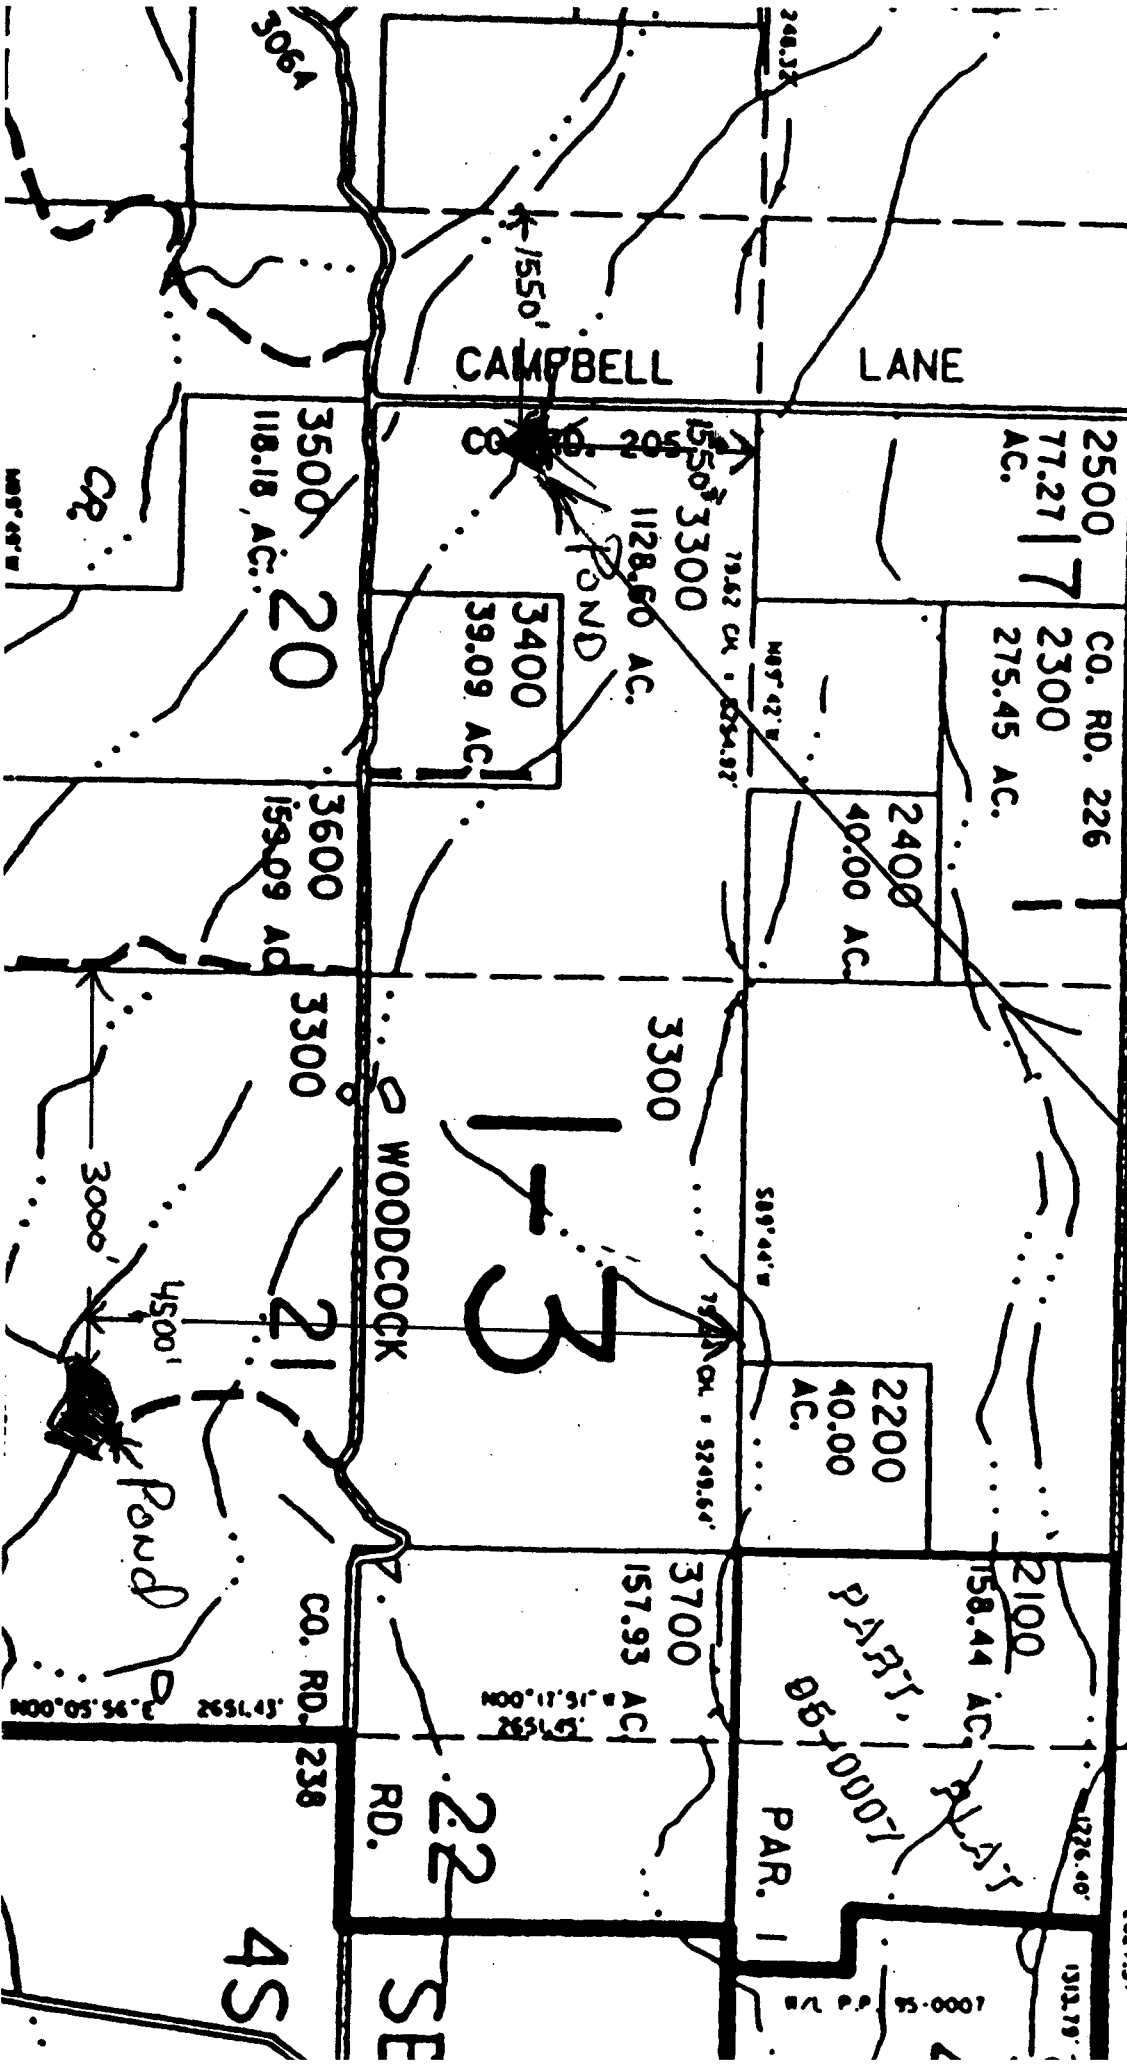

42.12 AC. 38.29
39.09 AC. 234.55 AC. THREEMILE CREEK
2500 AC. 77.27 | 7
CO. RD. 226
2300
275.45 AC.
2400
40.00 AC.
2200
40.00 AC.
2100
158.44 AC.
3700
157.93 AC.
RD. 226
RD. 238
45

CAMPBELL LANE
1550'
1550'
1128.50 AC.
3400
39.09 AC.
3600
159.09 AC.
3300
3300
3000'
4500'


3500
118.18 AC.
20


