




T. 4 S, R. 12 E, W.M.

RECEIVED

JAN 15 2003

WATER RESOURCES DEPT.  
SALEM, OREGON

Scale: 1" = 2000 feet

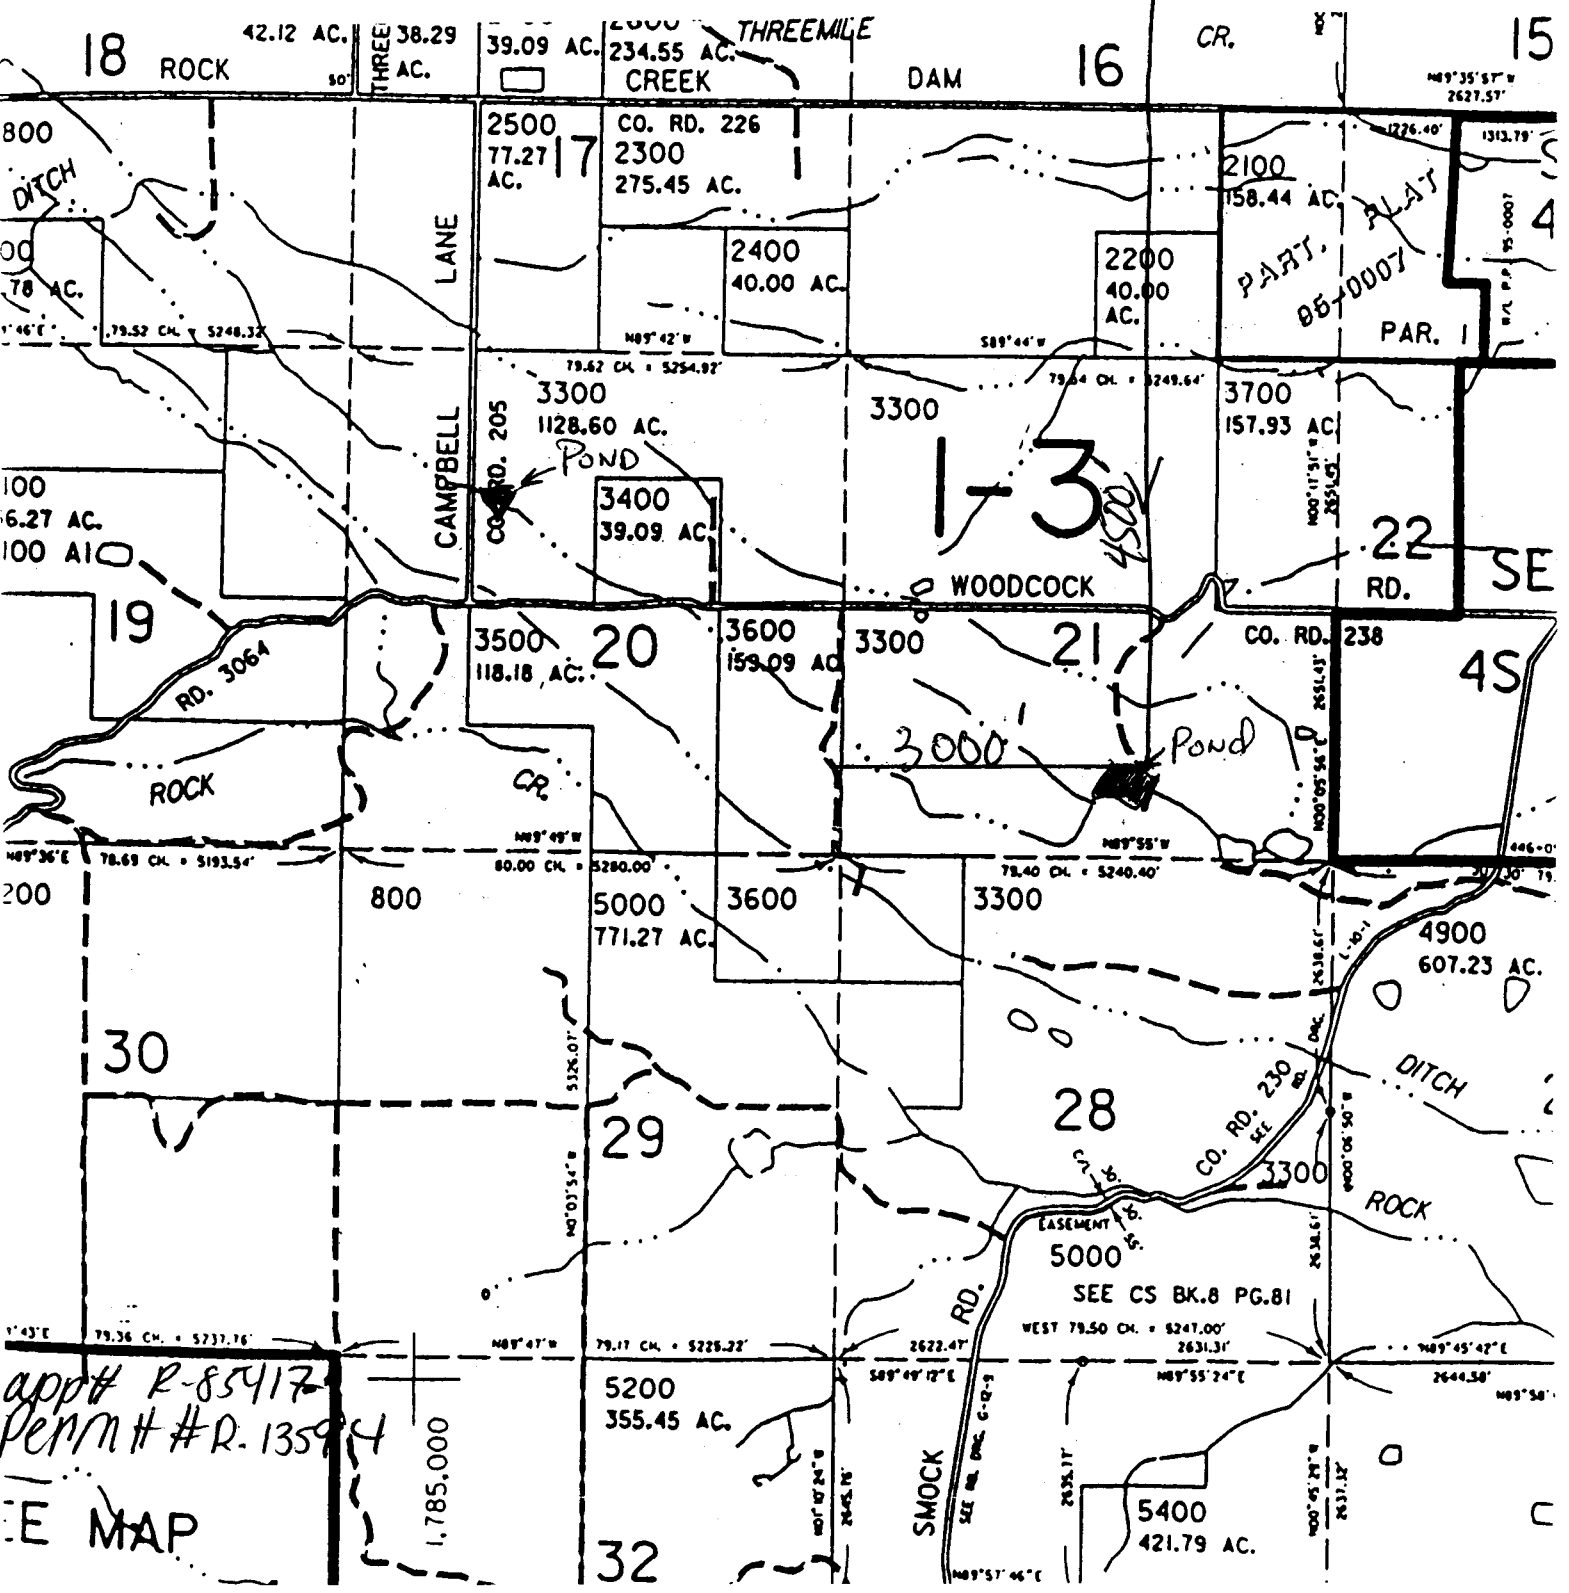

app# R-85417  
Permit # R-13594

E MAP