

APP # R. 85454
Permit # R-13605



28

1100

RECEIVED
FFR 04 2003
WATER RESOURCES DEPT.
SALEM, OREGON

1600
204.20 AC.

HIGHWAY

27

600

1500
77.27 AC.

ROCK

1400
2160.00 A

2

Pond location
1045 ft N. E.
745 ft W. of
Southeast corner
of section 27

JOHN LOGAN

LITTLE

RD 312

LANE

2000
316.55 AC.

OREGON

P1

2100
79.83 AC.

2200
558.35 AC.

BUCHANAN

801
355.76 AC.

33

PARCEL 1

34

CRANE


2002
304.04 AC.

SCALE = 1" = 1320 FT.

MAP 1 OF 2

TOWNSHIP 22 S, RANGE 33 E., W.M.

4000
2000
0
SCALE IN FEET

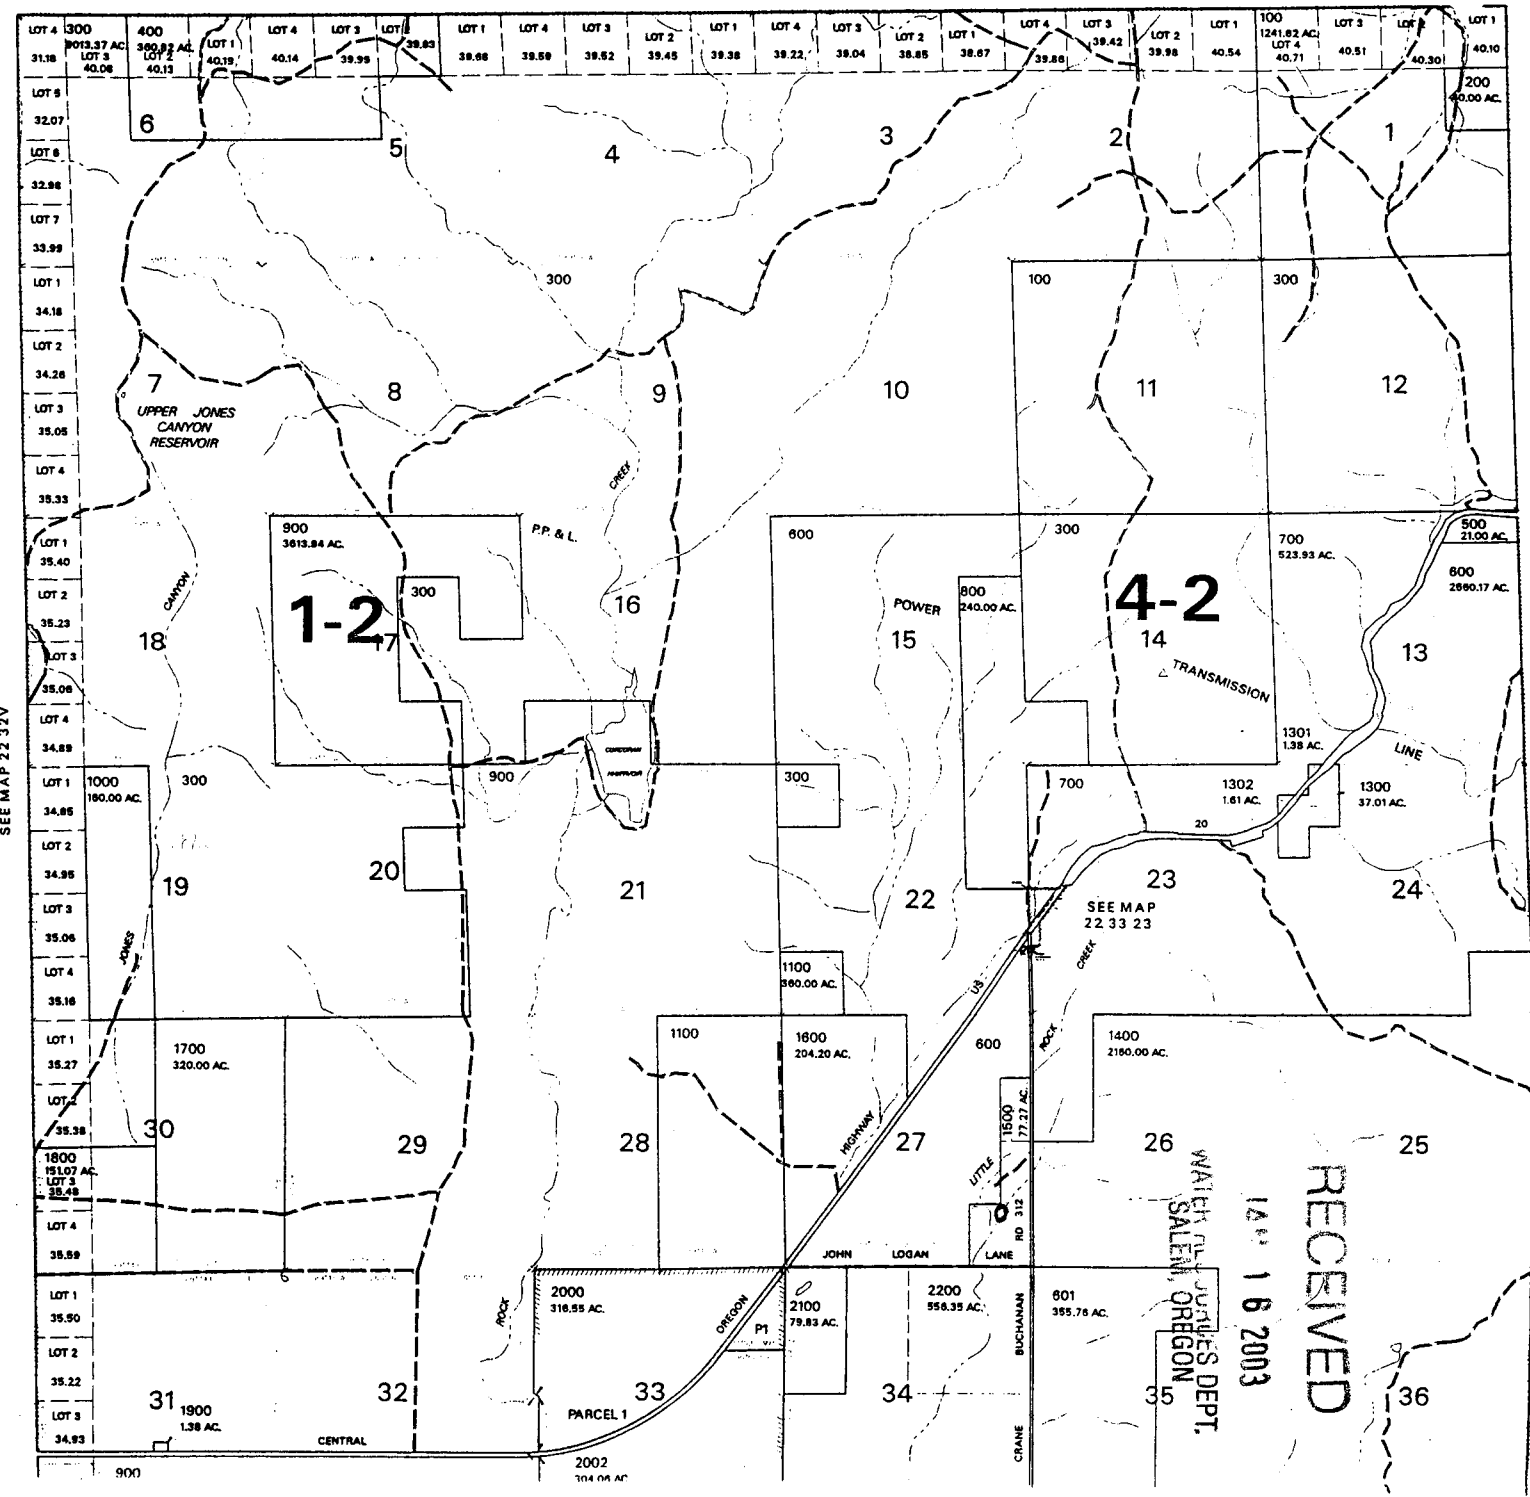

Dam Location
N 43° 37.560'
W 118° 37.894'

APP # R-85454

WATER RESOURCES DEPT.
SALEM, OREGON

RECEIVED
FEB 04 2003

RECEIVED
FEB 16 2003
WATER RESOURCES DEPT.
SALEM, OREGON

SEE MAP 22 34

MAP 2012