


Ron Vandecoevering
11607 Baron Rd

Mt. Angel, OR 97362
(503) 845-9490

9000

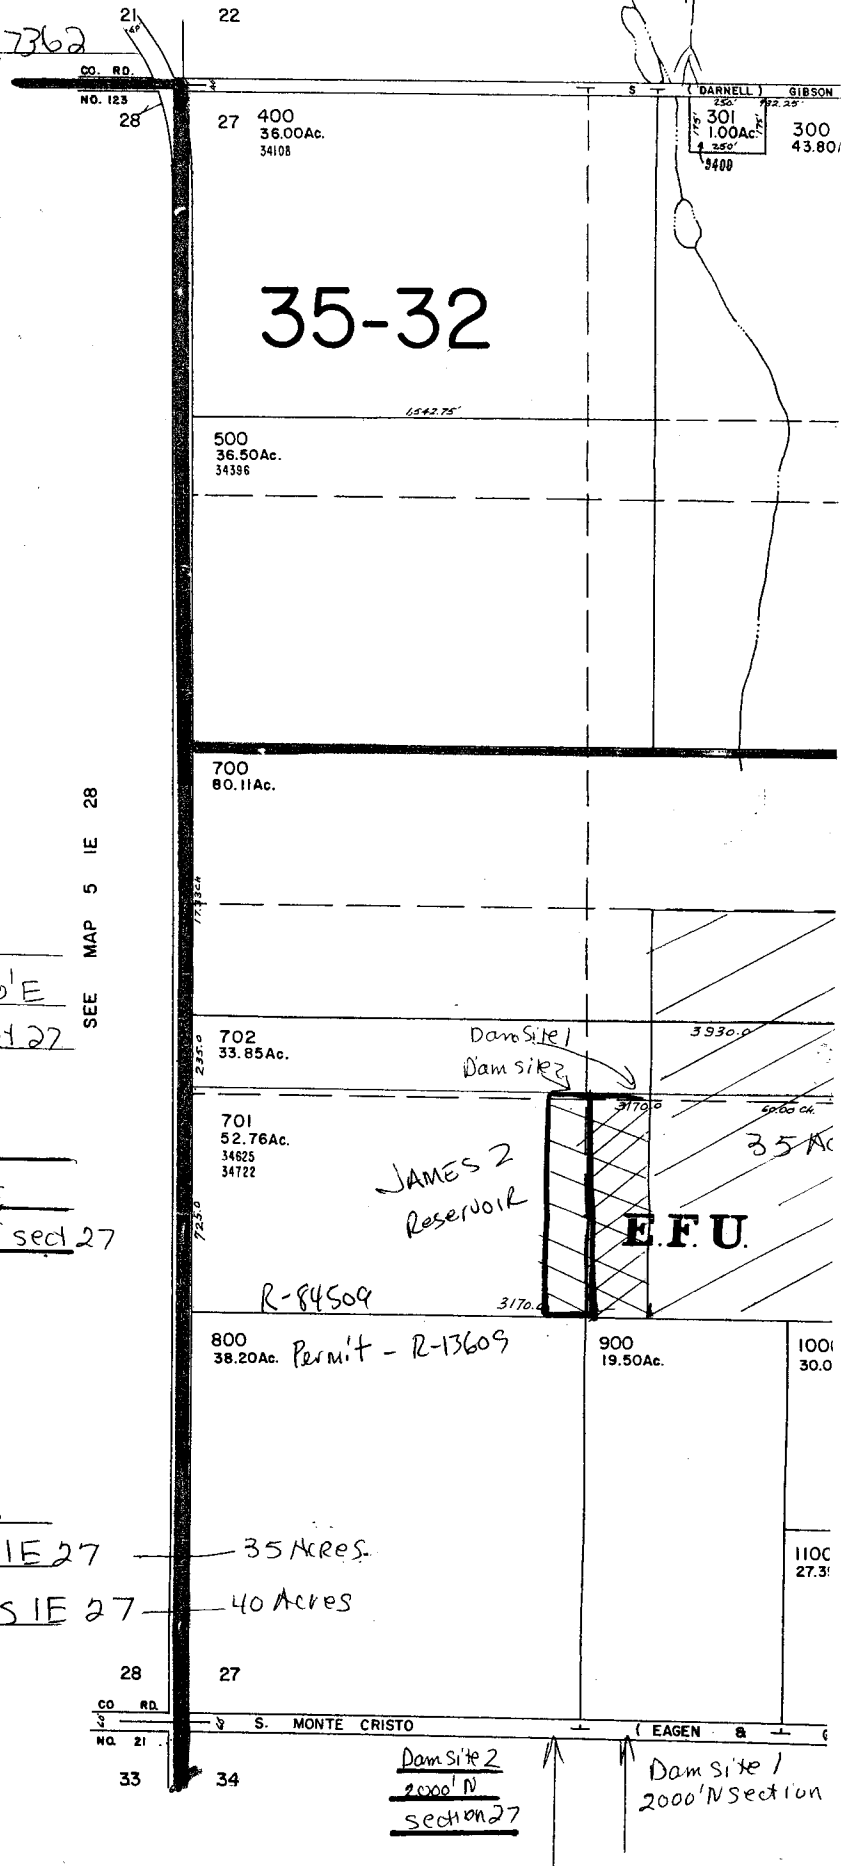

SEE MAP 5 IE 28

/// Dam Site 1
2000' N and 1400' E
From SW corner of sect 27

/// Dam Site 2
2000' N and 1200' E
From SW corner of sect 27

IRRIGATED Ground is
NE 1/4 of SW 1/4 S 5 E 27 — 35 Acres
NW 1/4 of SE 1/4 S 5 E 27 — 40 Acres

JAMES 2 Reservoir

E.F.U.

R-84509

800 38.20Ac. Permit - R-13609

900 19.50Ac.

1000 30.0

1100 27.3

Dam Site 2
2000' N
section 27

Dam Site 1
2000' N section

1" = 400'

AUG 24 2000


WATER RESOURCES DEPT
SALEM, OR

SEE MAP 5 IE 22

9600

10000

34000

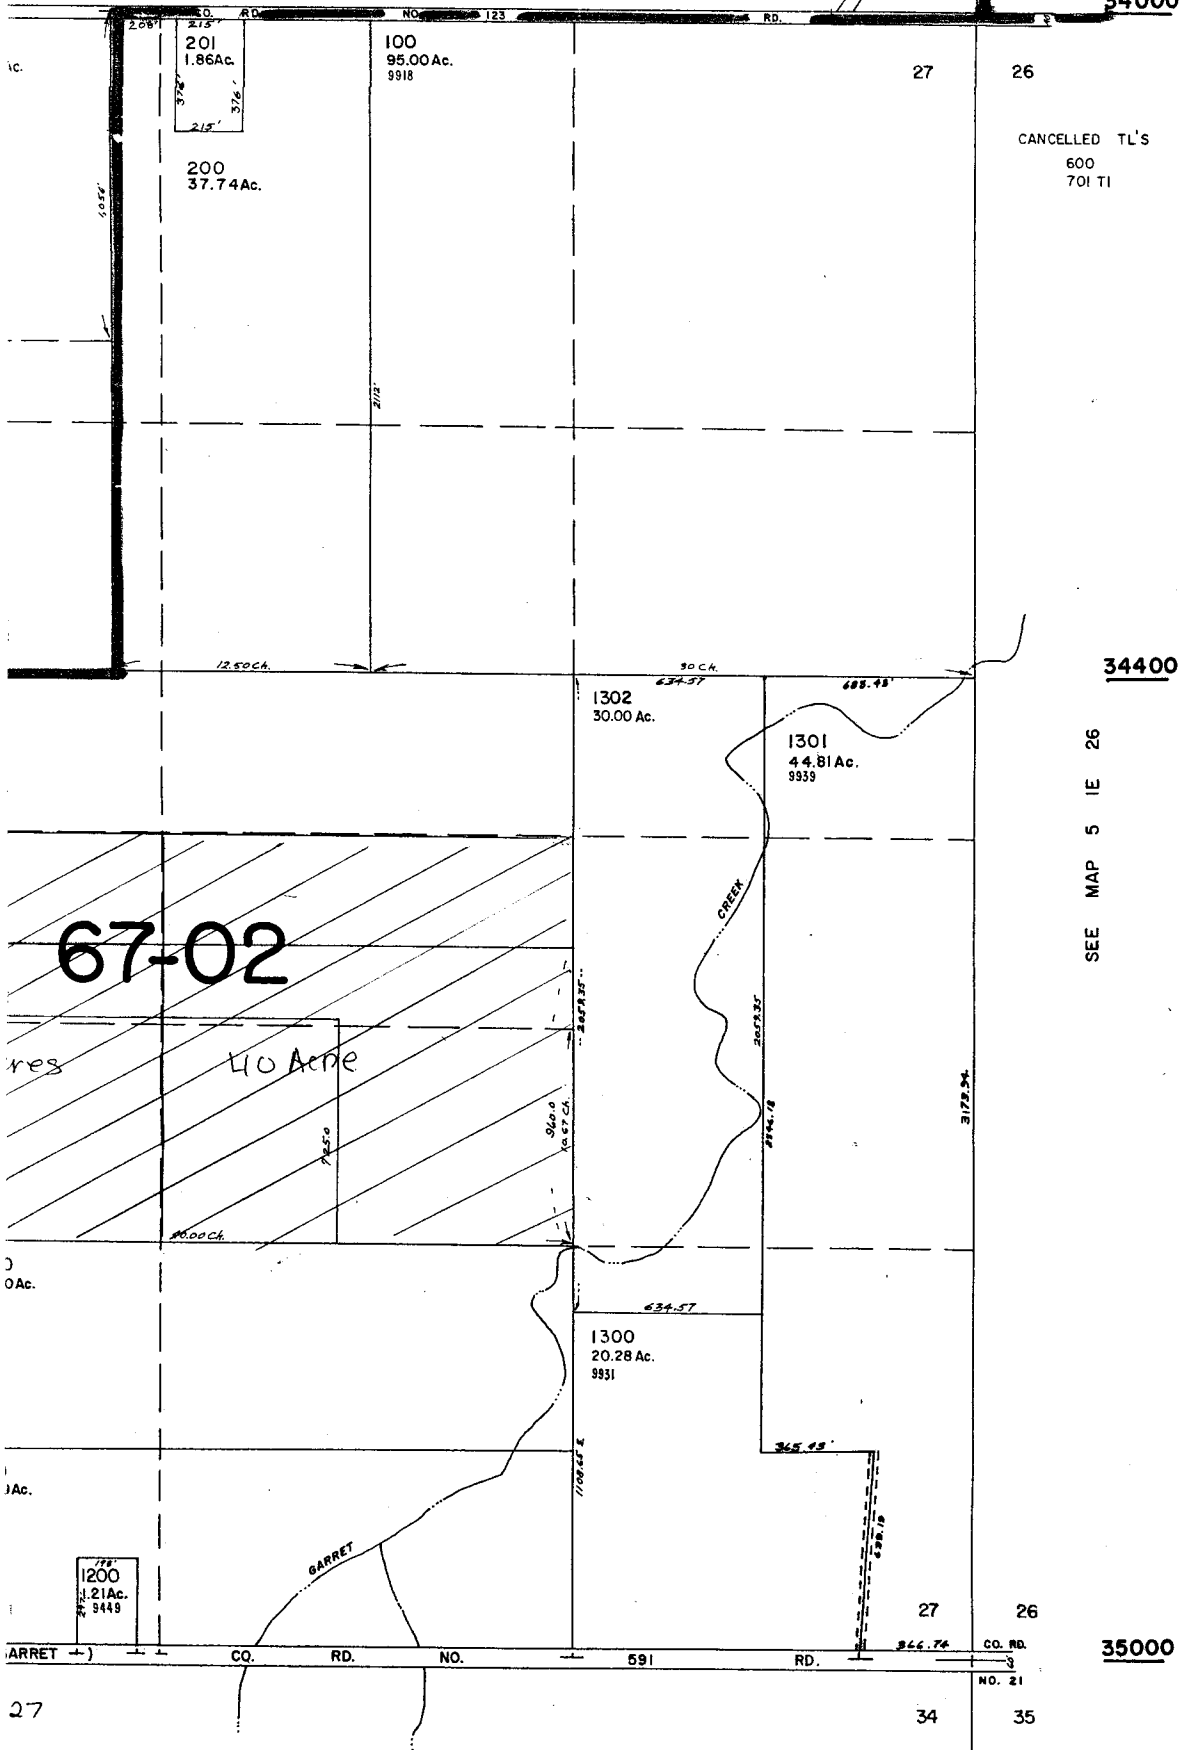

CANCELLED TL'S
600
701 TI

34400

67-02

40 Acre

CREEK

GARRET

SILVER

1200
1.21 Ac.
9449

1300
20.28 Ac.
9931

1301
44.81 Ac.
9939

1302
30.00 Ac.

200
37.74 Ac.

201
1.86 Ac.

100
95.00 Ac.
9918

SEE MAP 5 IE 26

SEE MAP 5 IE 34

5 IE 27