app # R-85484
Permit # R-13641

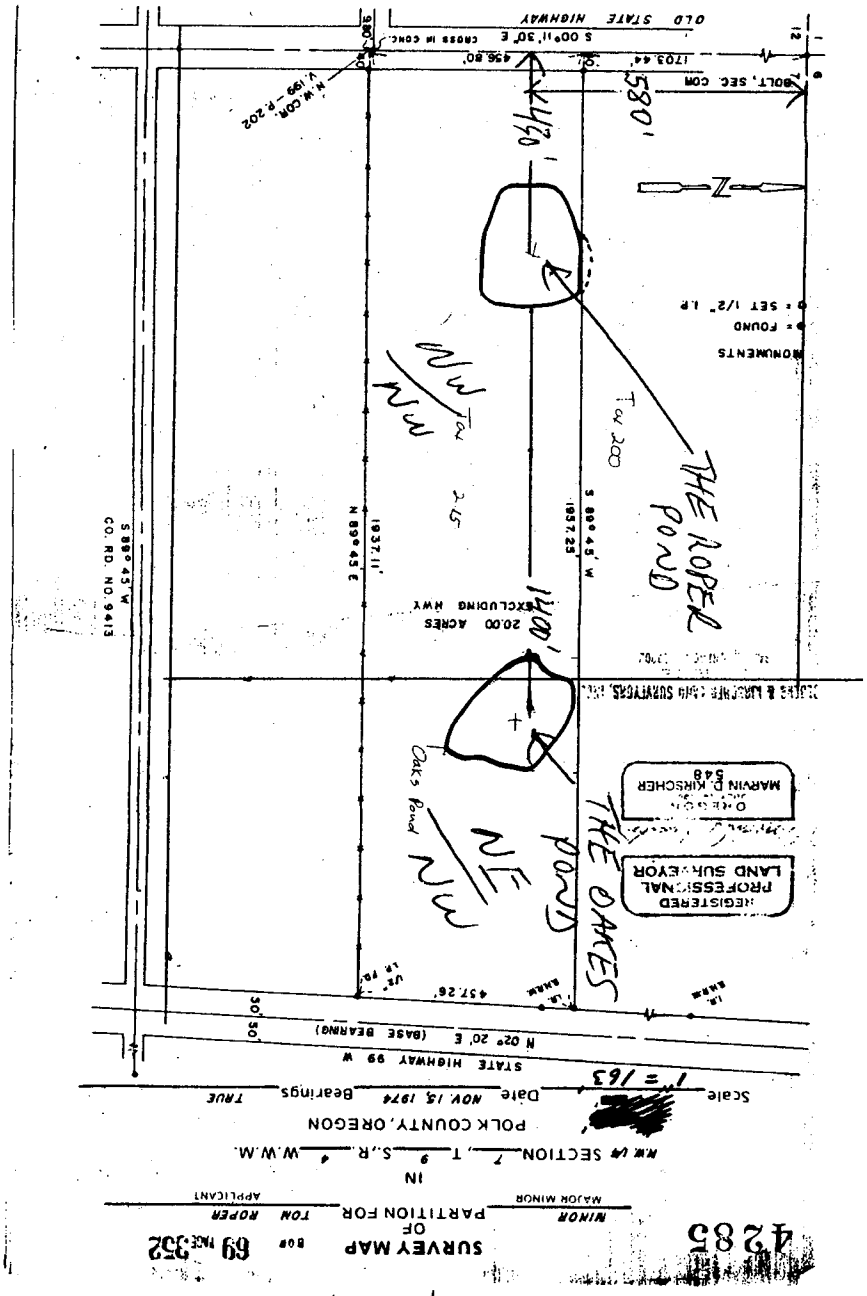

MAR - 4 2003