SECTION 13 T.3S. R.37E. W.M.
UNION COUNTY
1" = 400'

SEE MAP 3S 37

RECEIVED
MAR 17 2003
WATER RESOURCES DEPT.
SALEM, OREGON

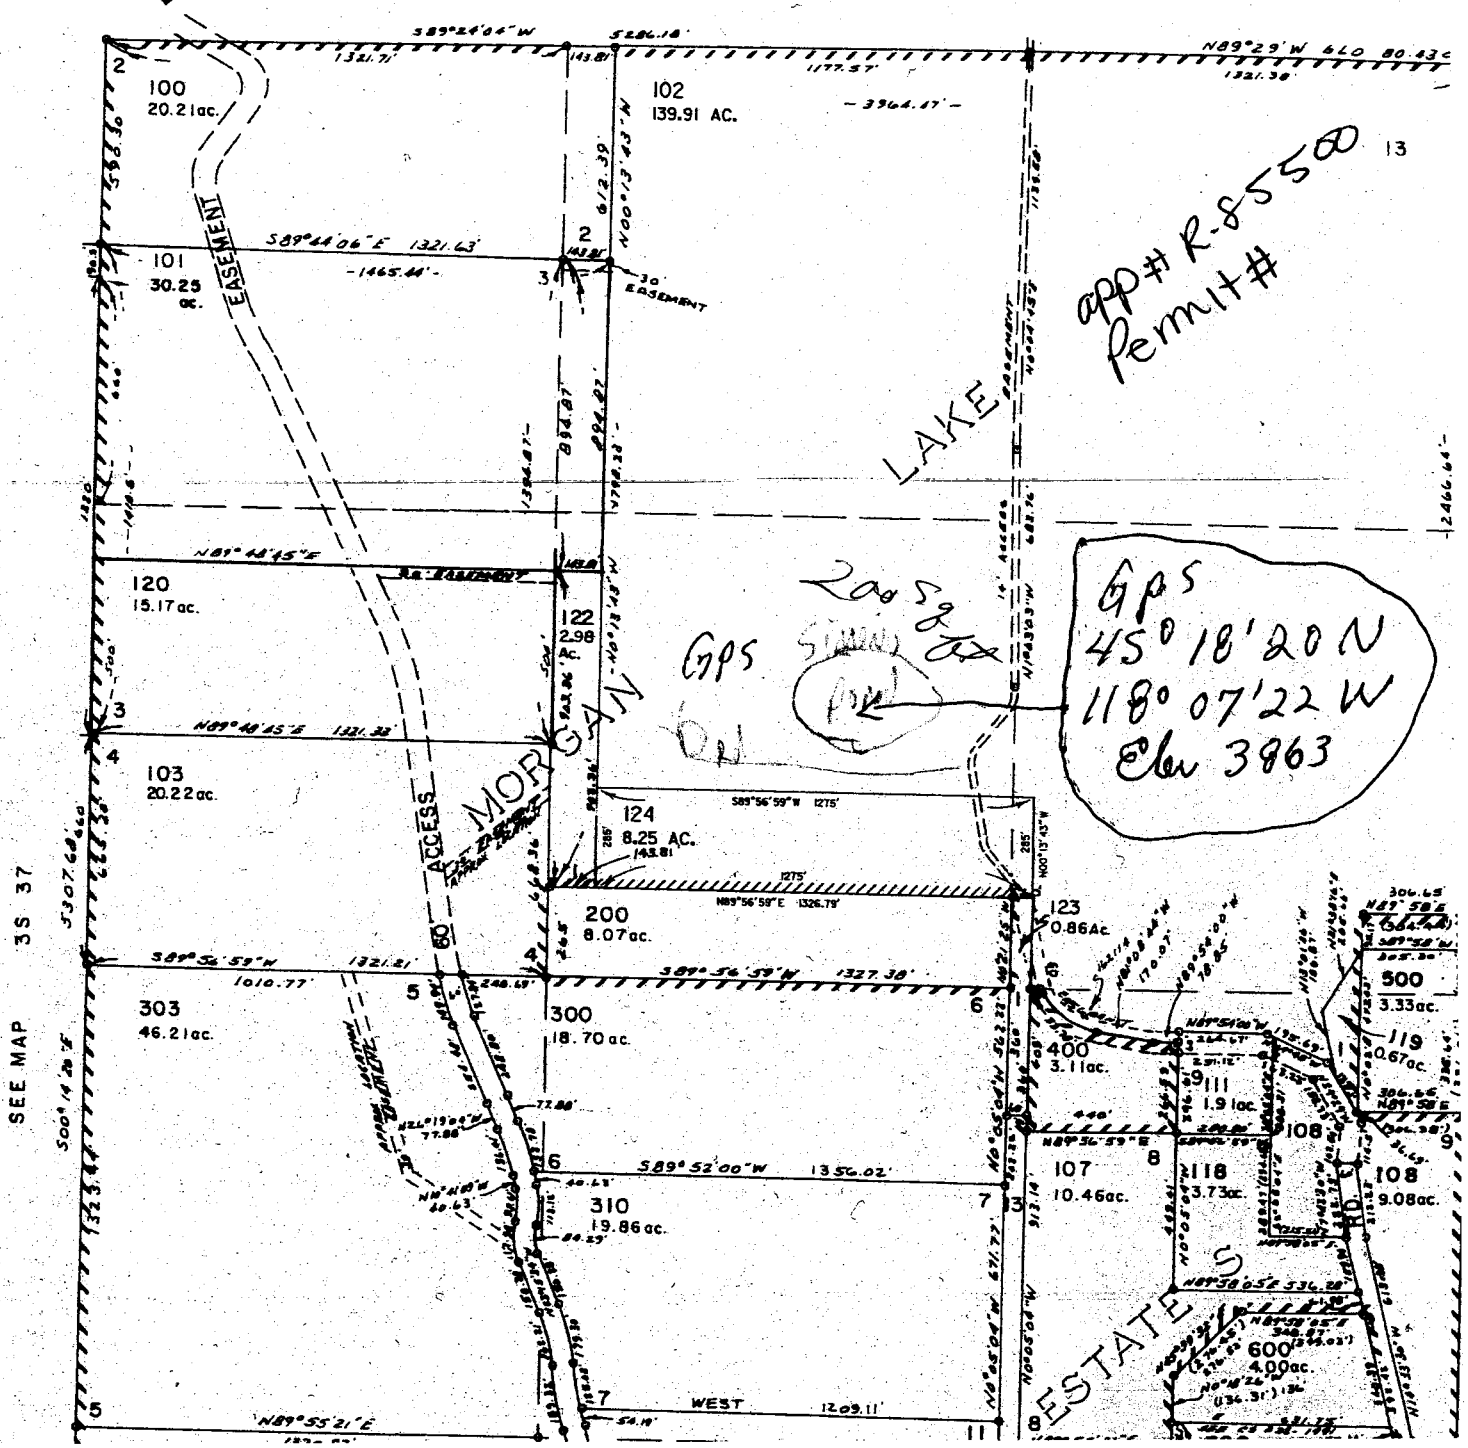

-3

app # R-85500
Permit # R-13648