


SEC. 15 T.25S. R. 6W W.M.  
DOUGLAS COUNTY

WILCOX FAMILY FARM LLC WETLAND ENHANCEMENT  
SEE MAP 25 6 10

REVISED ON  
6-2-97



SCALE 1" = 660'

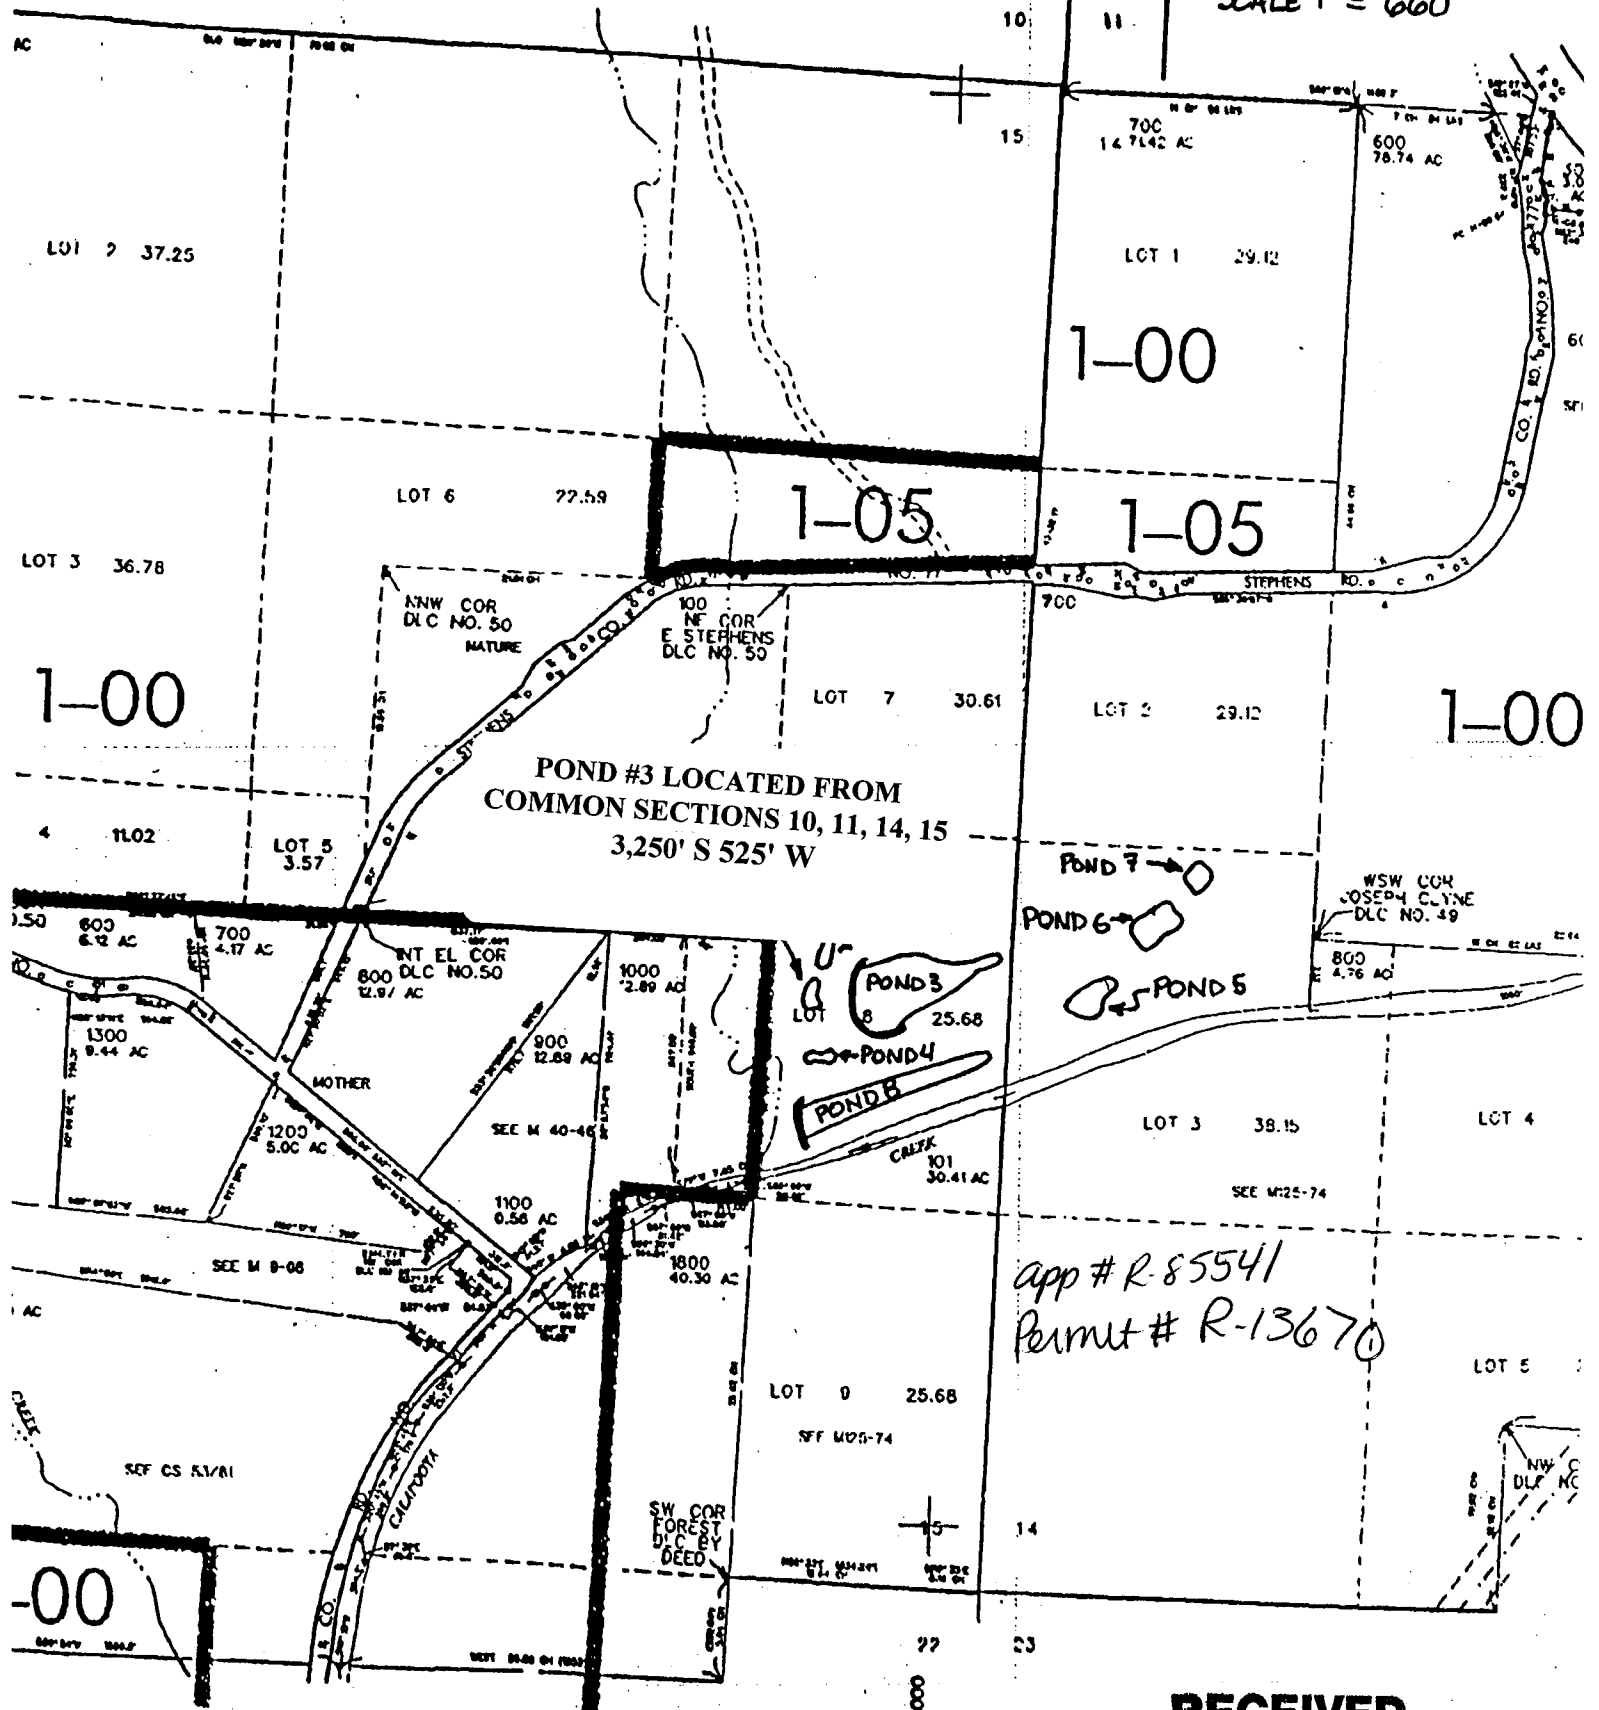

POND #3 LOCATED FROM  
COMMON SECTIONS 10, 11, 14, 15  
3,250' S 525' W

app # R-85541  
Permit # R-13670

RECEIVED  
APR 07 2003

SEE MAP 25 6 22

4,354,000