


SEC. 15 T.25S. R. 6W W.M.
DOUGLAS COUNTY

WILCOX FAMILY FARM LLC WETLAND ENHANCEMENT
REVISED ON 8-4-97
SEE MAP 25 6 10

SCALE 1" = 660'

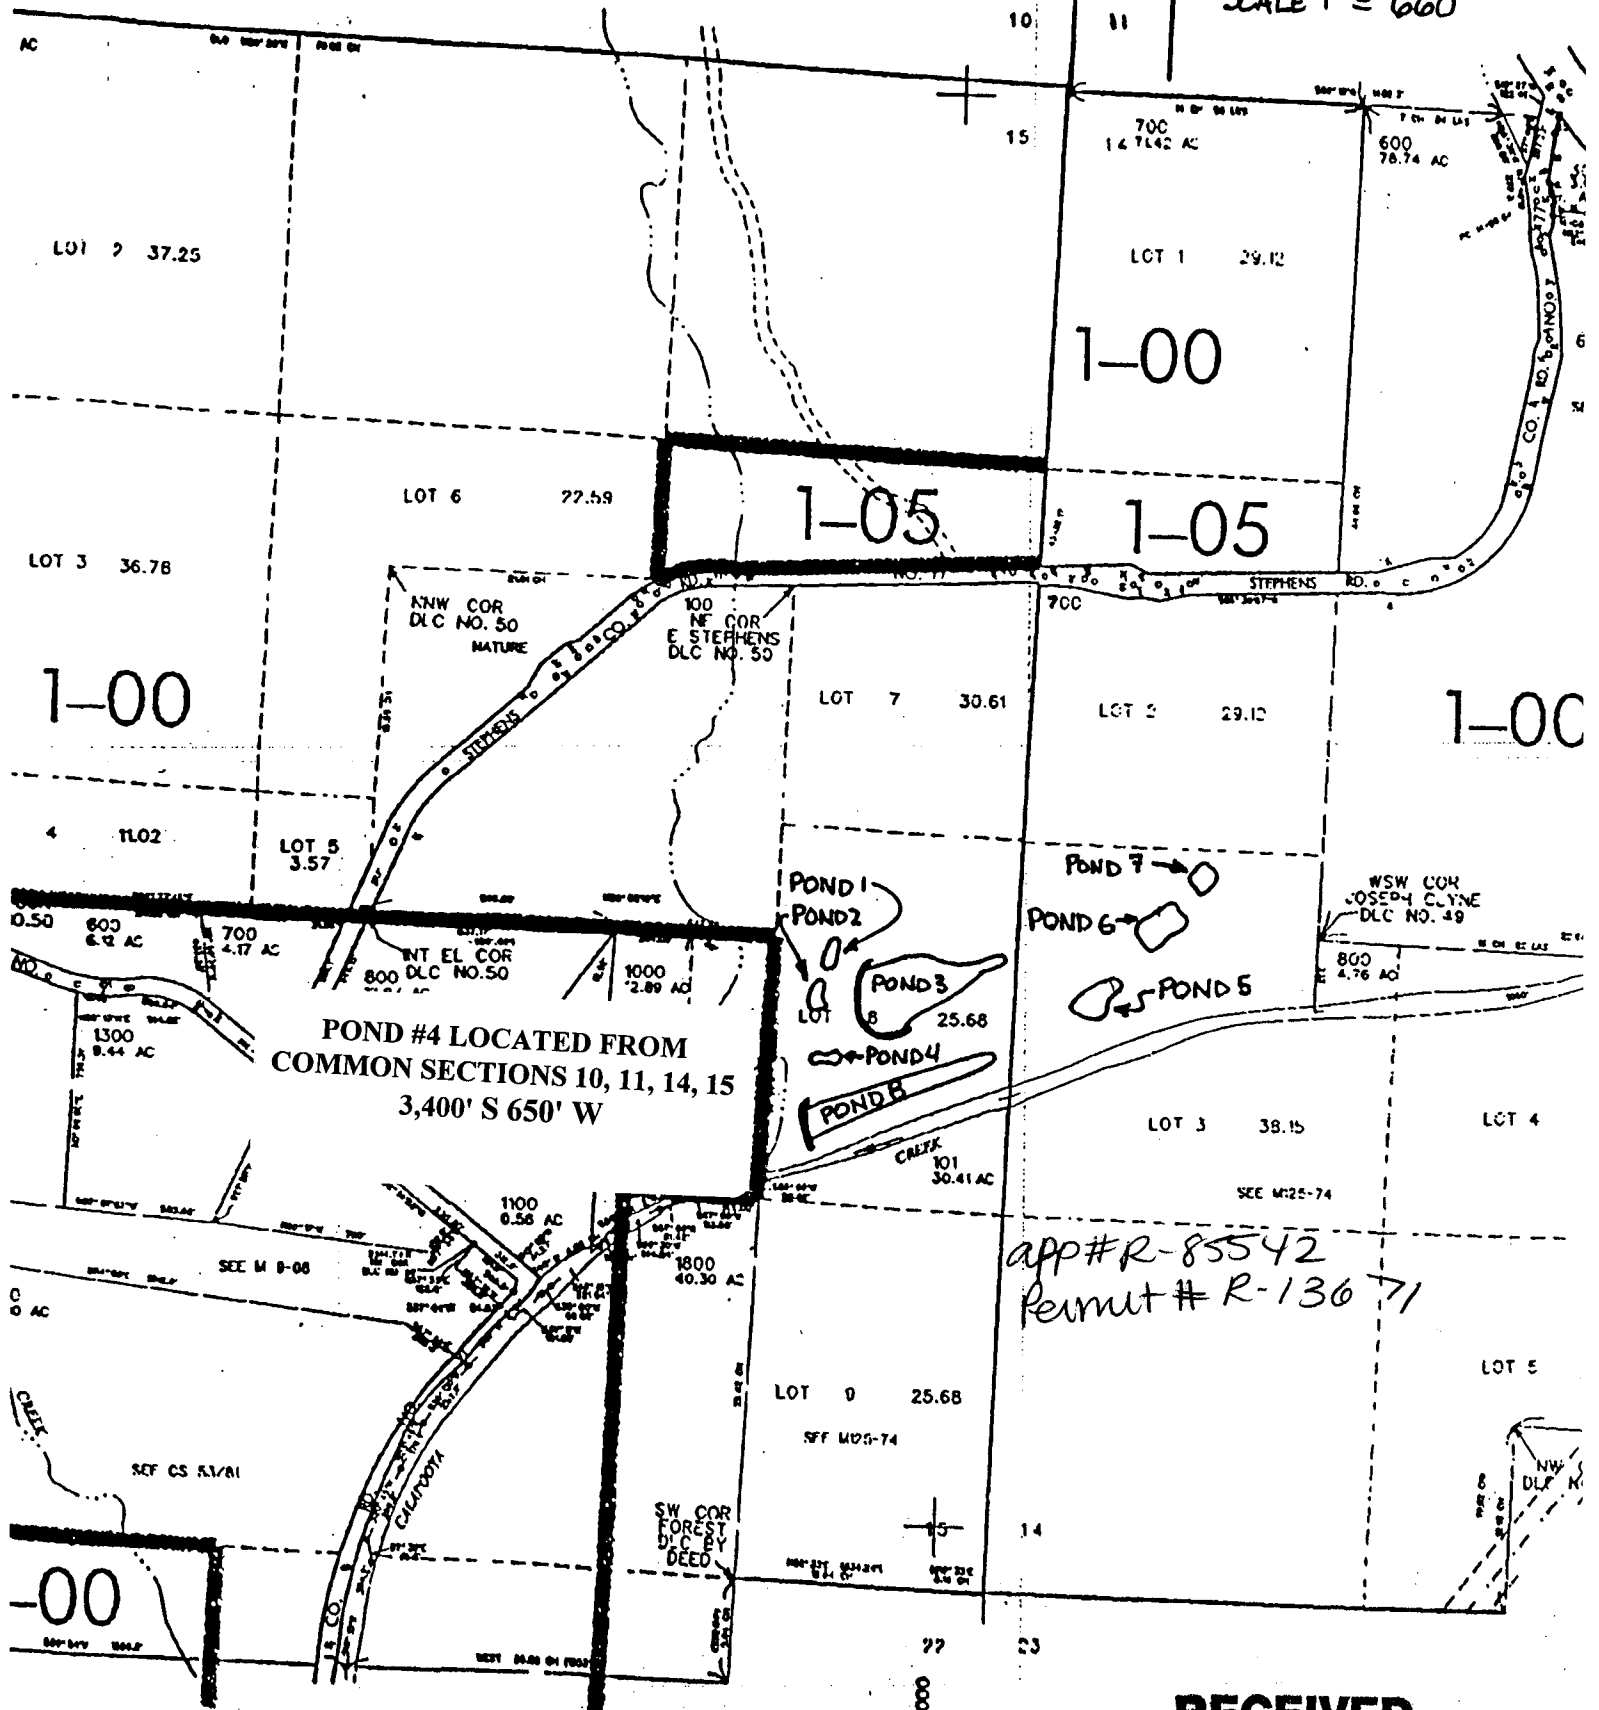

POND #4 LOCATED FROM
COMMON SECTIONS 10, 11, 14, 15
3,400' S 650' W

app# R-85542
Permit # R-13671

RECEIVED
APR 07 2003

SEE MAP 25 6 22

4,754,000