


SEC. 15 T.25S. R. 6W W.M.
DOUGLAS COUNTY

WILCOX FAMILY FARM LLC WETLAND ENHANCEMENT
SEE MAP 25 6 10

REVISED ON
6-4-97



SCALE 1" = 660'

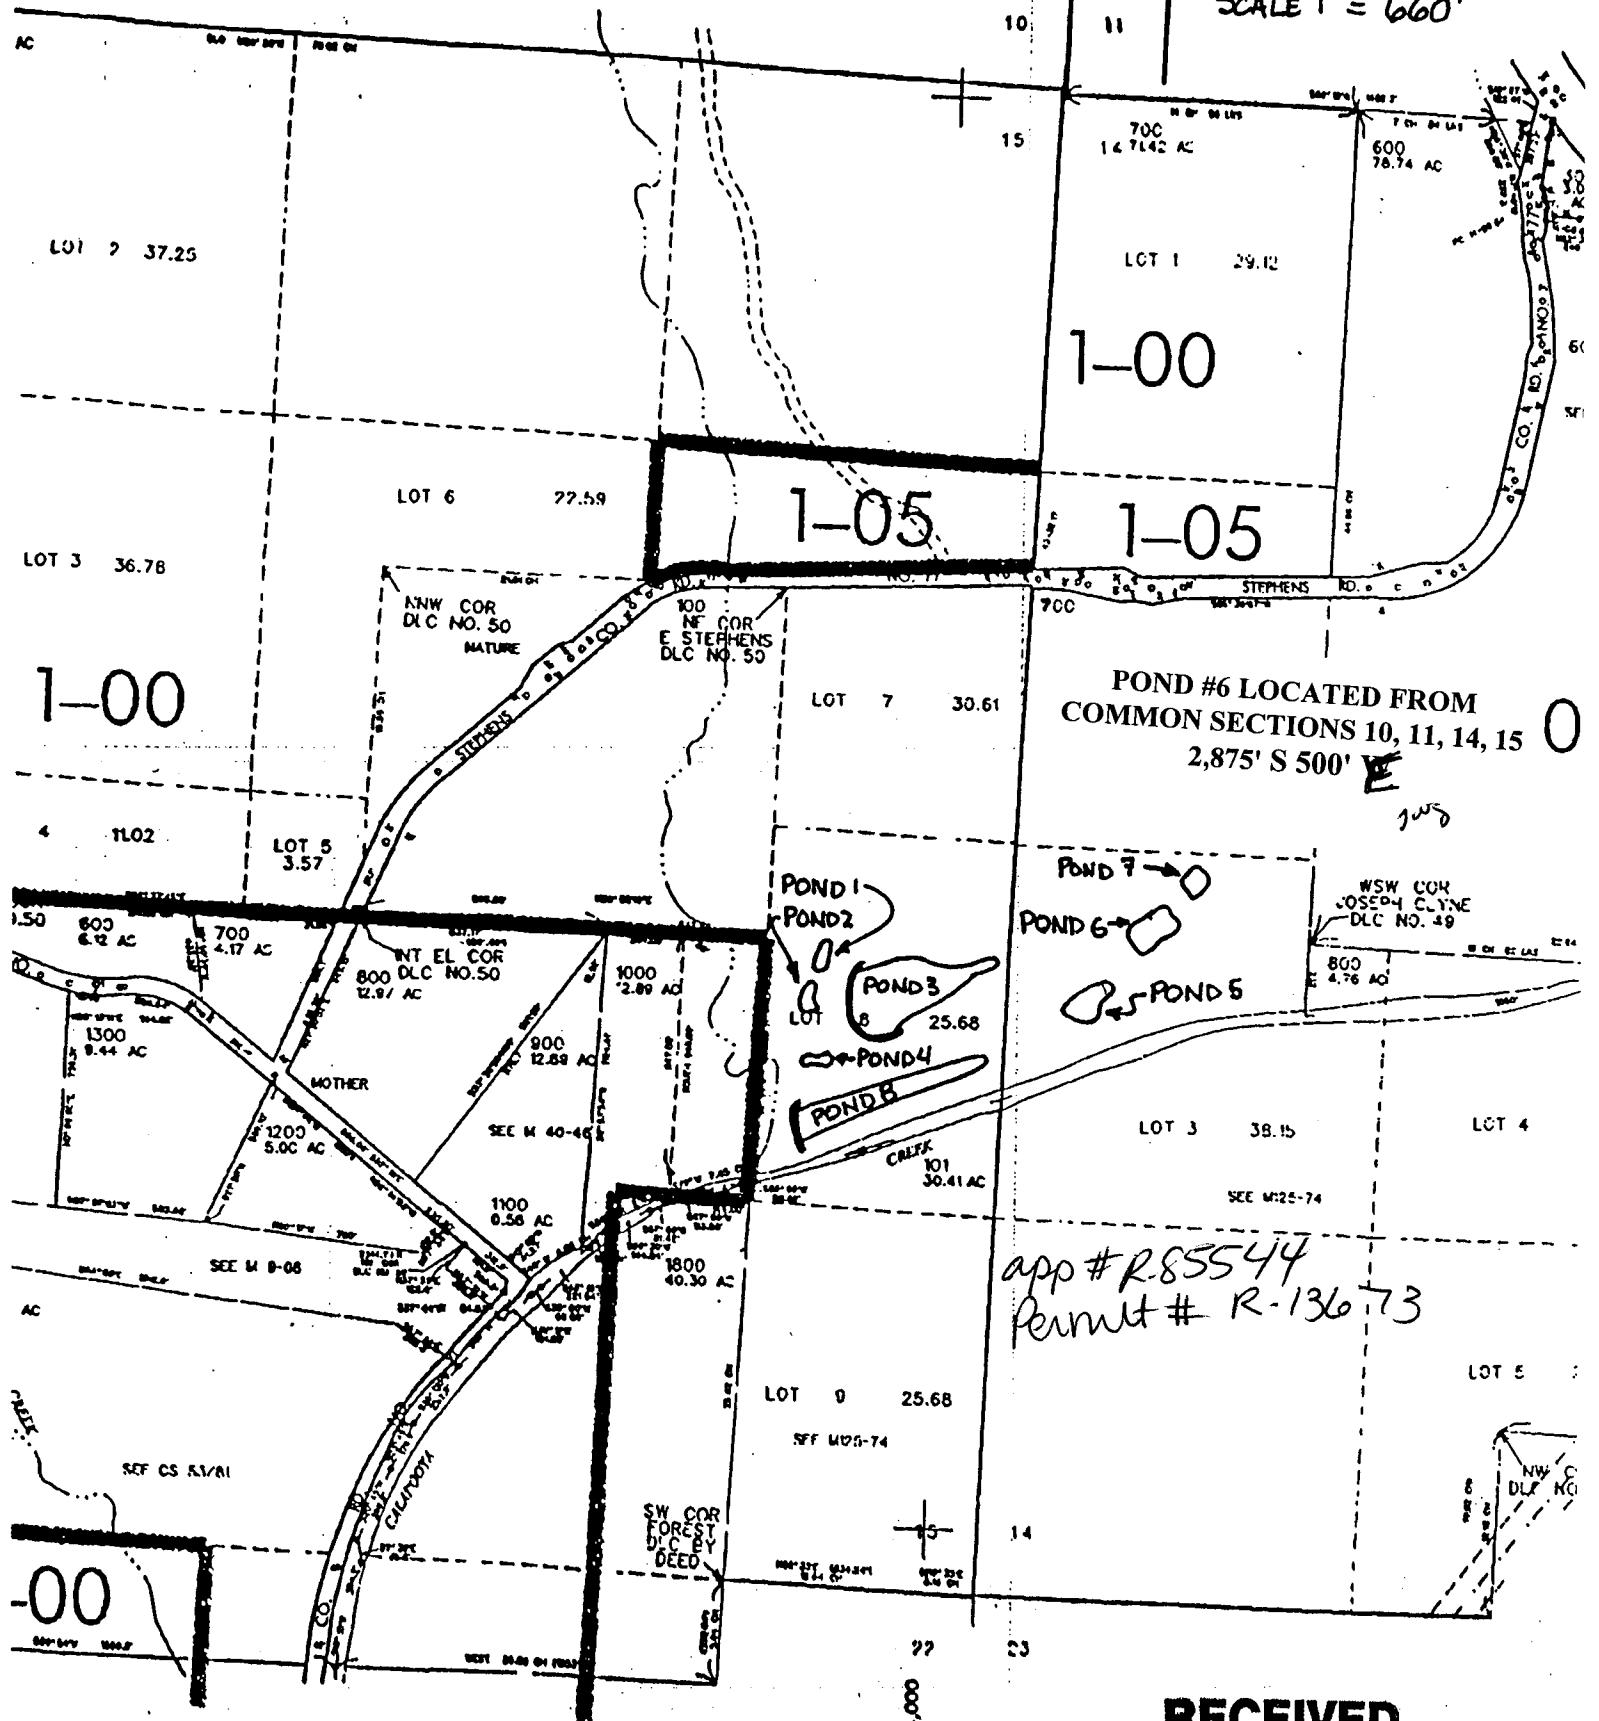

POND #6 LOCATED FROM
COMMON SECTIONS 10, 11, 14, 15
2,875' S 500' E

app # R-85544
Permit # R-13673

RECEIVED
APR 07 2003

SEE MAP 25 6 22

4,34,000