


SEC. 15 T.25S. R. 6W W.M.
DOUGLAS COUNTY

WILCOX FAMILY FARM LLC WETLAND ENHANCEMENT
REVISED ON 6-4-97
SEE MAP 25 6 10



SCALE 1" = 660'

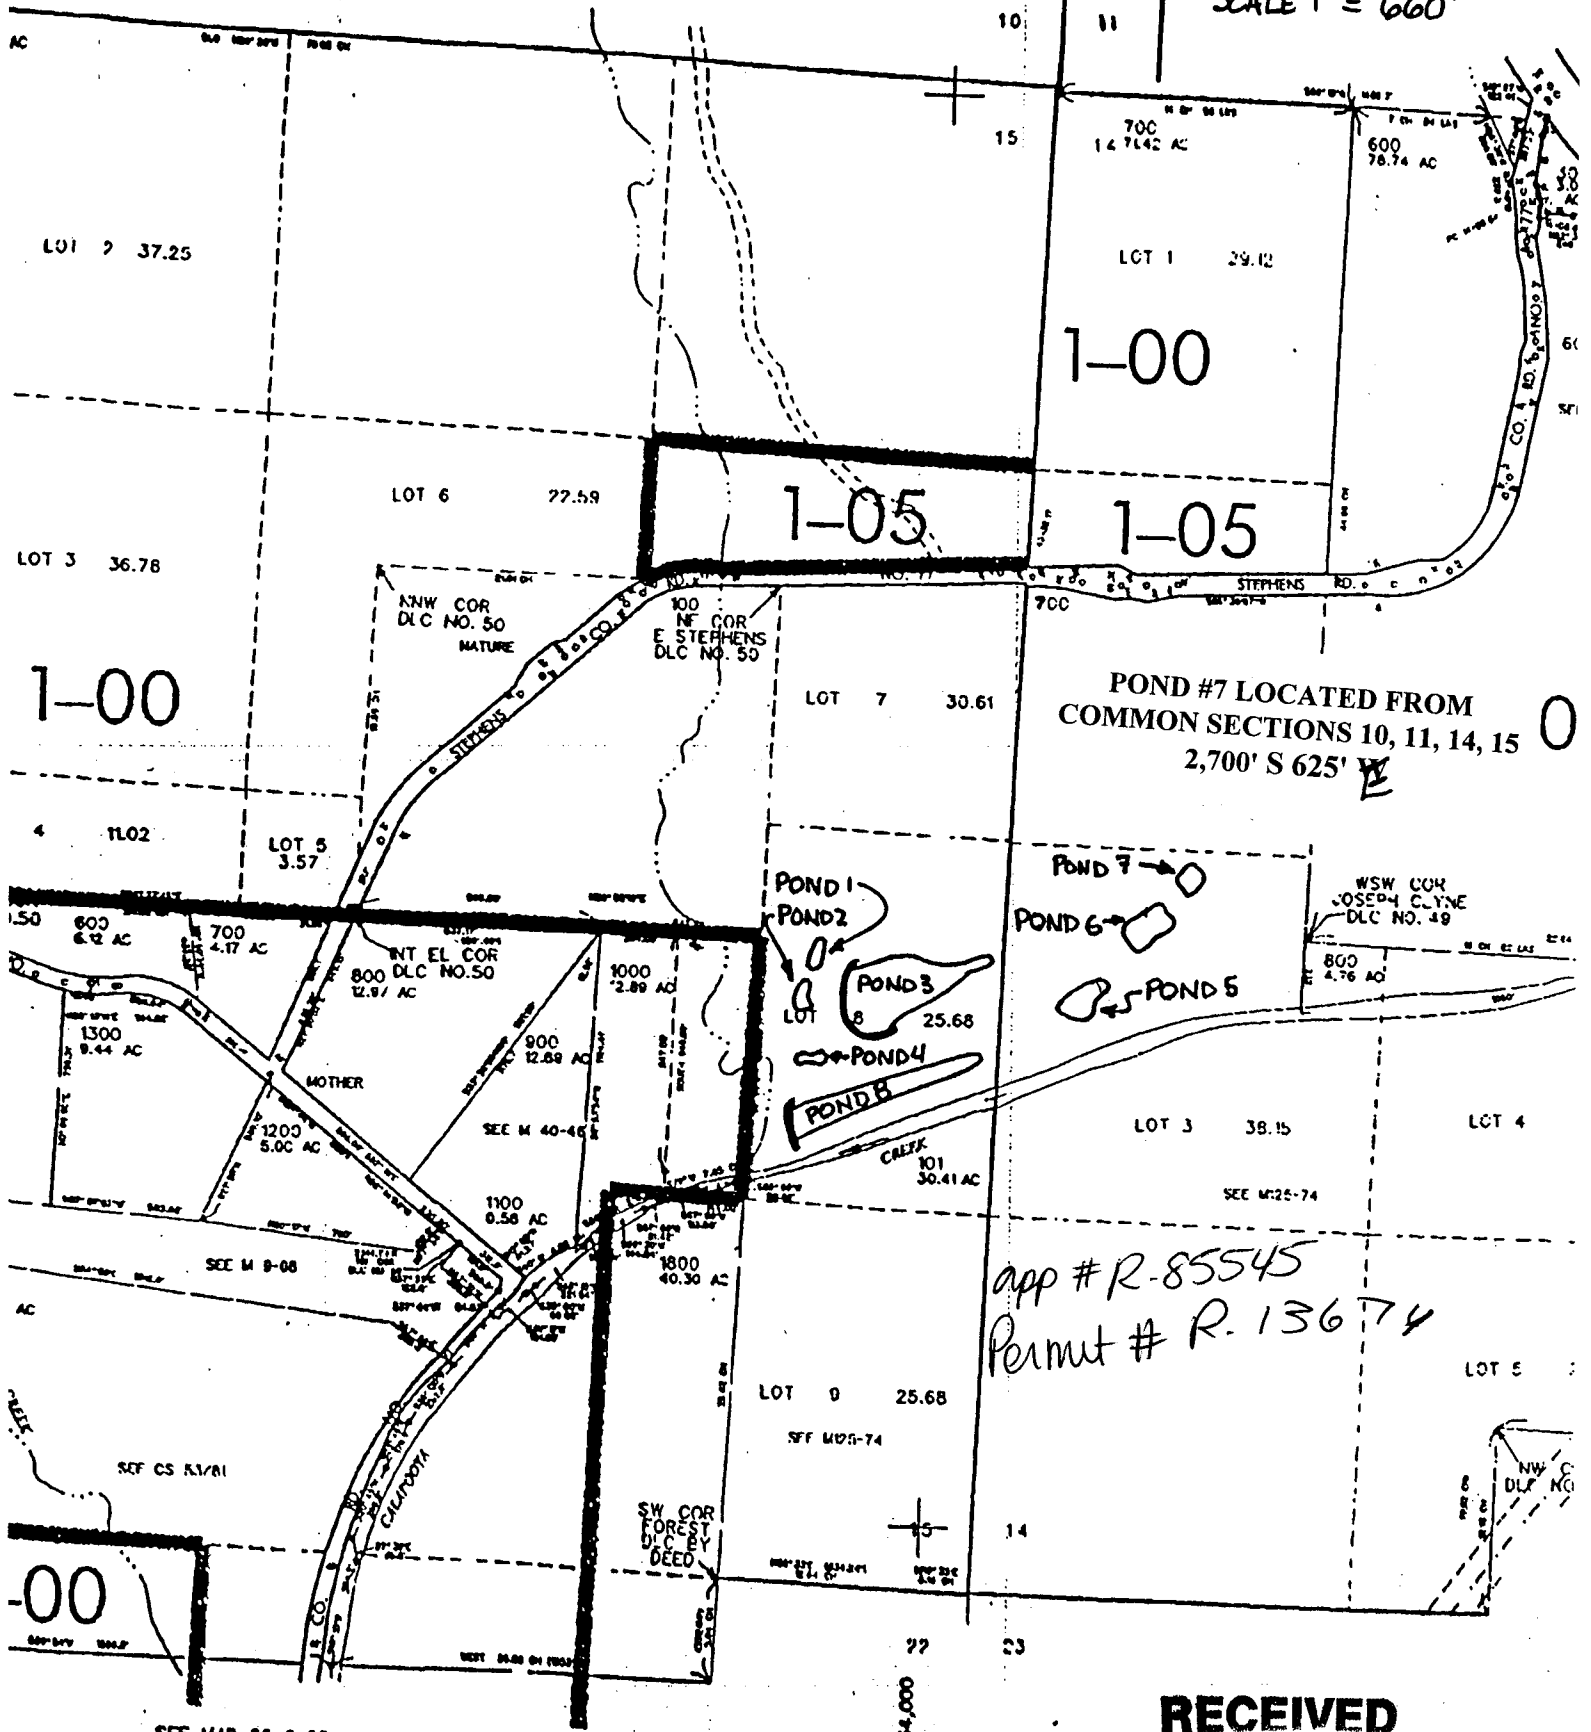

POND #7 LOCATED FROM
COMMON SECTIONS 10, 11, 14, 15
2,700' S 625' E

app # R-85545
Permit # R.13674

RECEIVED
APR 07 2003

SEE MAP 25 6 22