


SEE MAP 35 6 29C

SEE MAP 35 6 29D

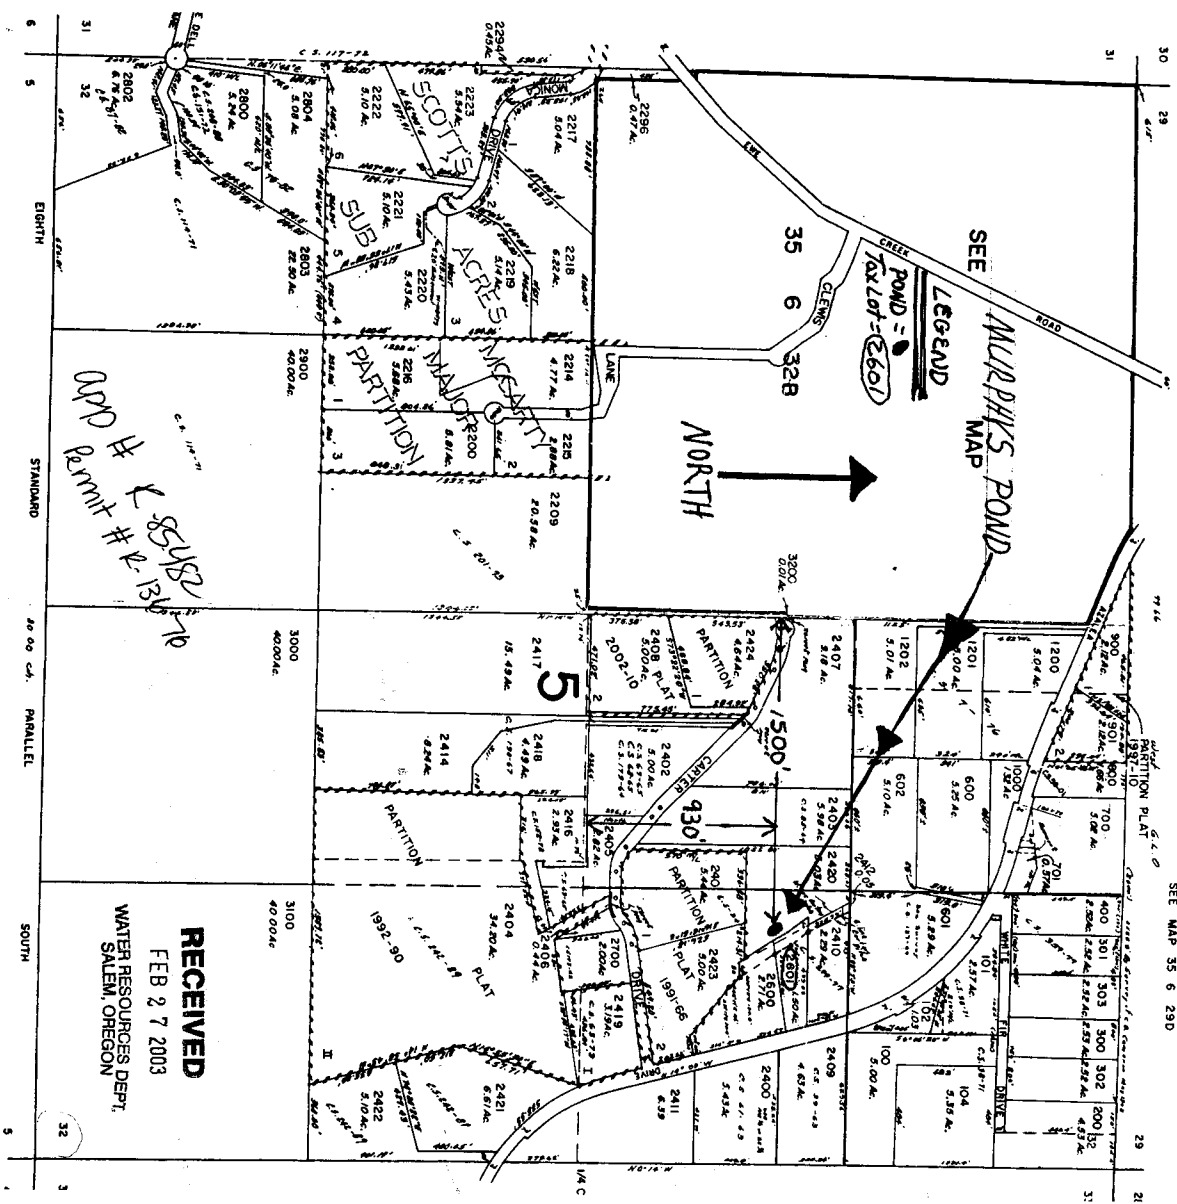

Map # 2838
2839
2840
RECEIVED
FEB 27 2003
WATER RESOURCES DEPT.
SALEM, OREGON