


RECEIVED
FEB 15 1990

App # R-85538 \$

1" = 800 FT

T. 7 S. R. 5 W. Sec 2

752

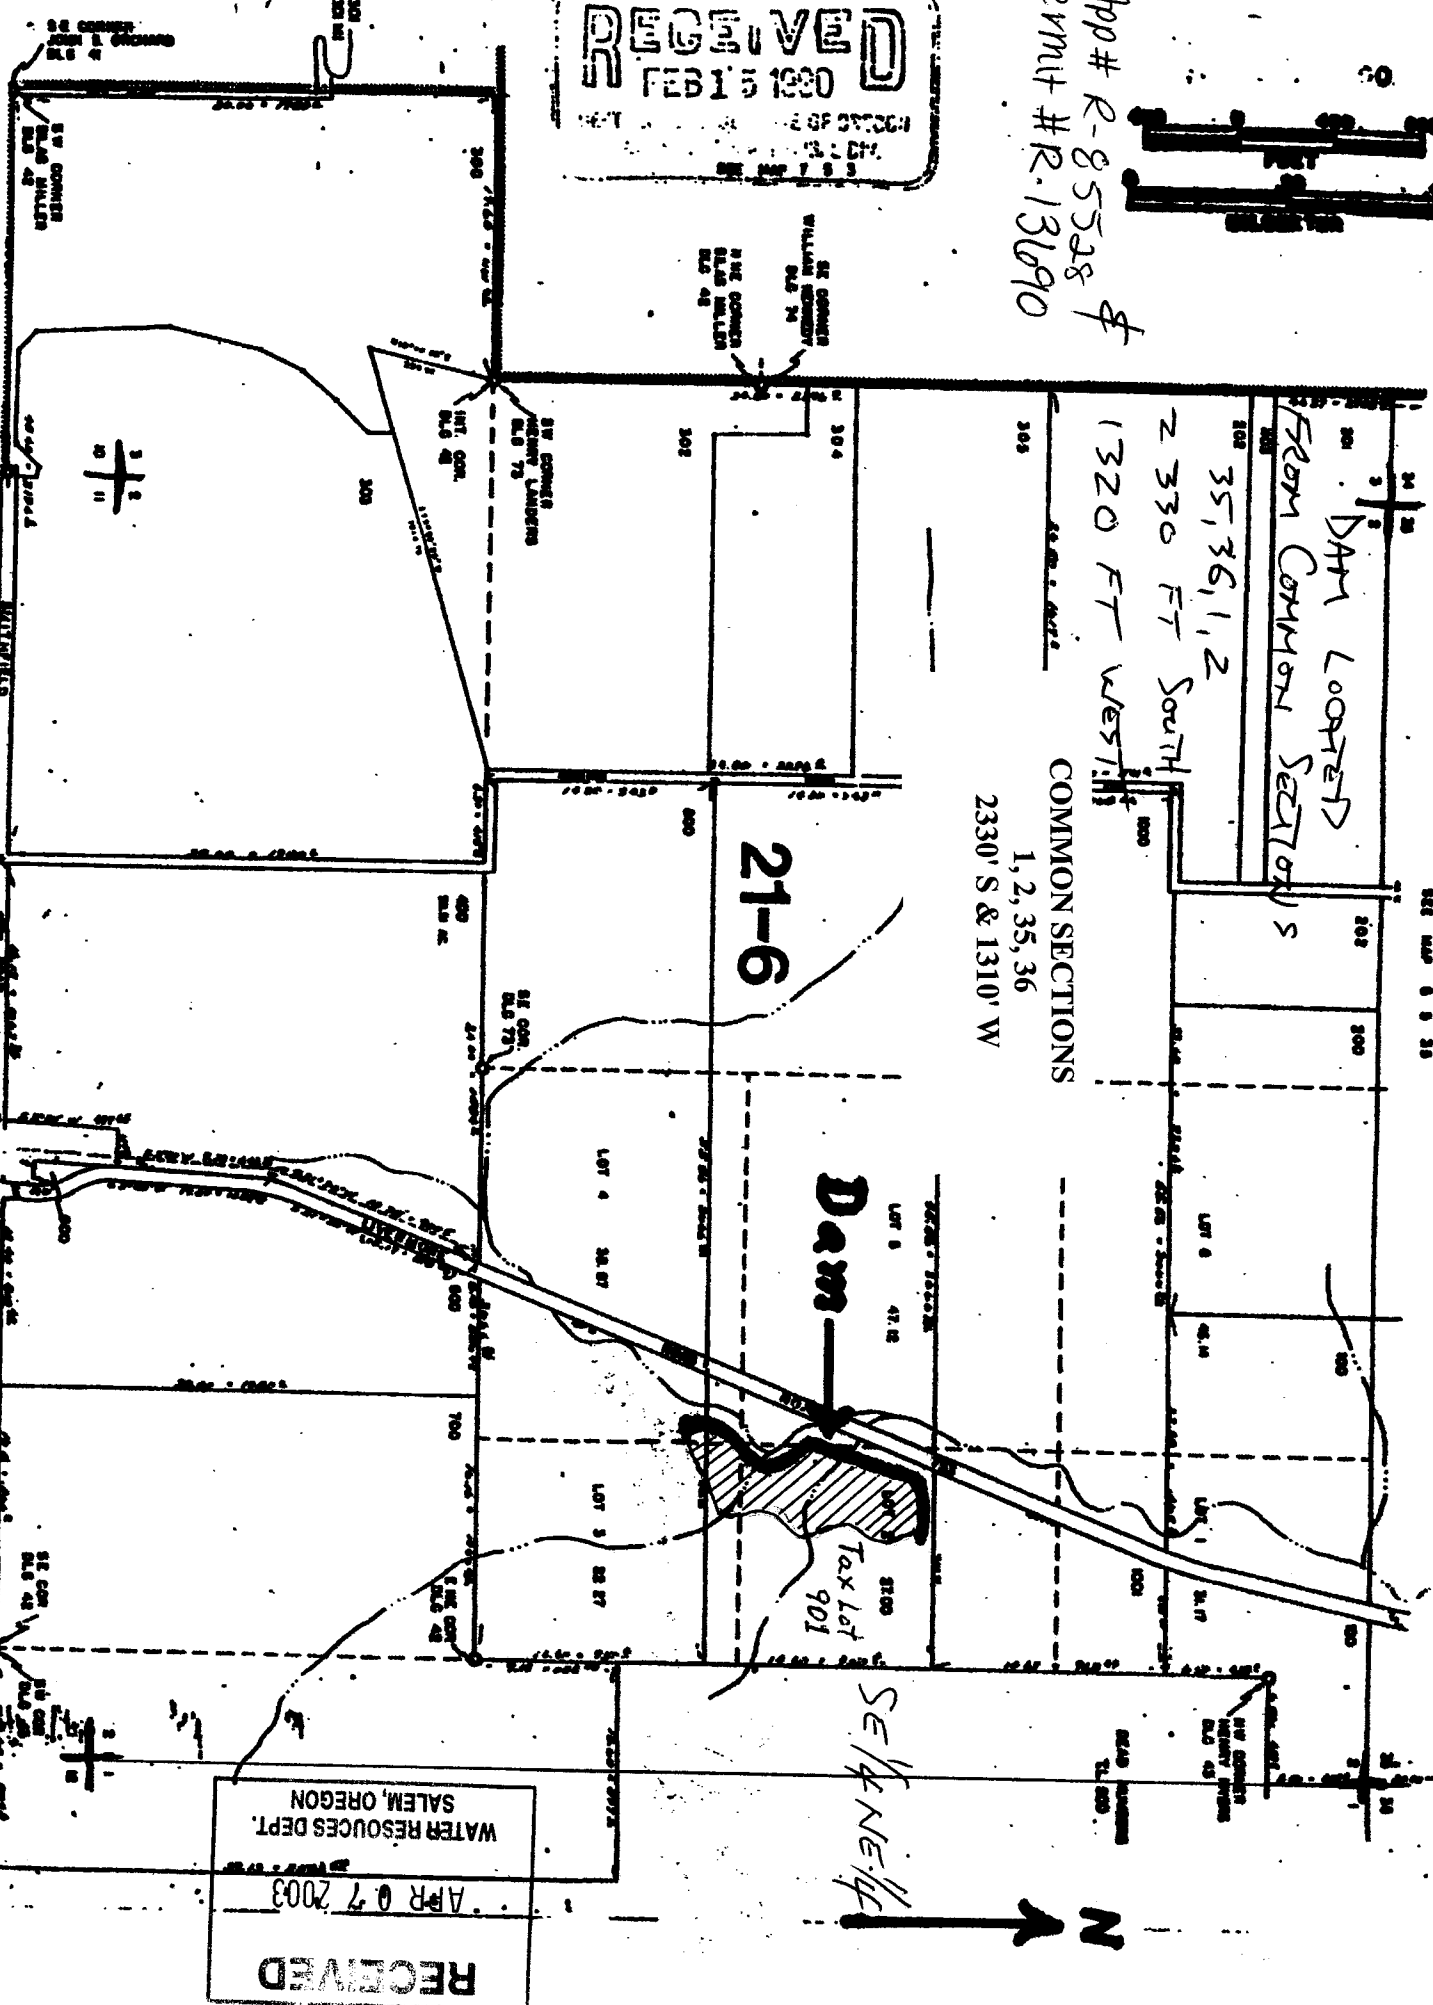

RECEIVED
APR 07 2003
WATER RESOURCES DEPT.
SALEM, OREGON

N
SE/NE 1/4