

LEGEND

LINE TYPES

- TAX LOT BOUNDARY OLD PROPERTY LINE
- ROAD RIGHT-OF-WAY VACATED RIGHT-OF-WAY
- RAILROAD RAILROAD RIGHT-OF-WAY
- STREAM, LAKE, ETC. STREAM, LAKE, ETC.
- TAX LOT BOUNDARY TAX LOT BOUNDARY
- SUBDIVISION BOUNDARY PARTITION PLAT BDY.
- TAX CODE BOUNDARY EASEMENT

SYMBOL TYPES

- D.L.C.
- CONTROL POINTS
- SURVEY MONUMENTS
- C.L.O. CORNERS
- SECTION 1/4 SEC 1/16 SEC
- 1/4 COR 1/16 COR

NUMBERS

TAX CODE NO.
000 00 00 0

ACREAGE - ALL ACREAGES EXCLUDE ANY PORTION THAT MAY LIE WITHIN THE INDICATED PUBLIC RIGHT OF WAY.

TICK MARKS - WHEN A TICK MARK IS INDICATED ON THE EXTENSION OF A LINE, THEN THE DIMENSION GOES TO THE TICK MARK. GENERALLY THIS IS USED WHEN DIMENSIONS GO INTO PUBLIC RIGHT OF WAYS.



ARROWS ARE USED WITH DIMENSIONS IN AREAS OF GREATER COMPLEXITY.


NOTICE: This map was created for Assessor's Office use ONLY.



SCALE 1" = 200'
or 1:2400

Plot file created: February 27, 1998
\\ms01\forms\ap02\051w30c.gri

SW1/4 SEC.30 T5S R1W WM, MARION COUNTY

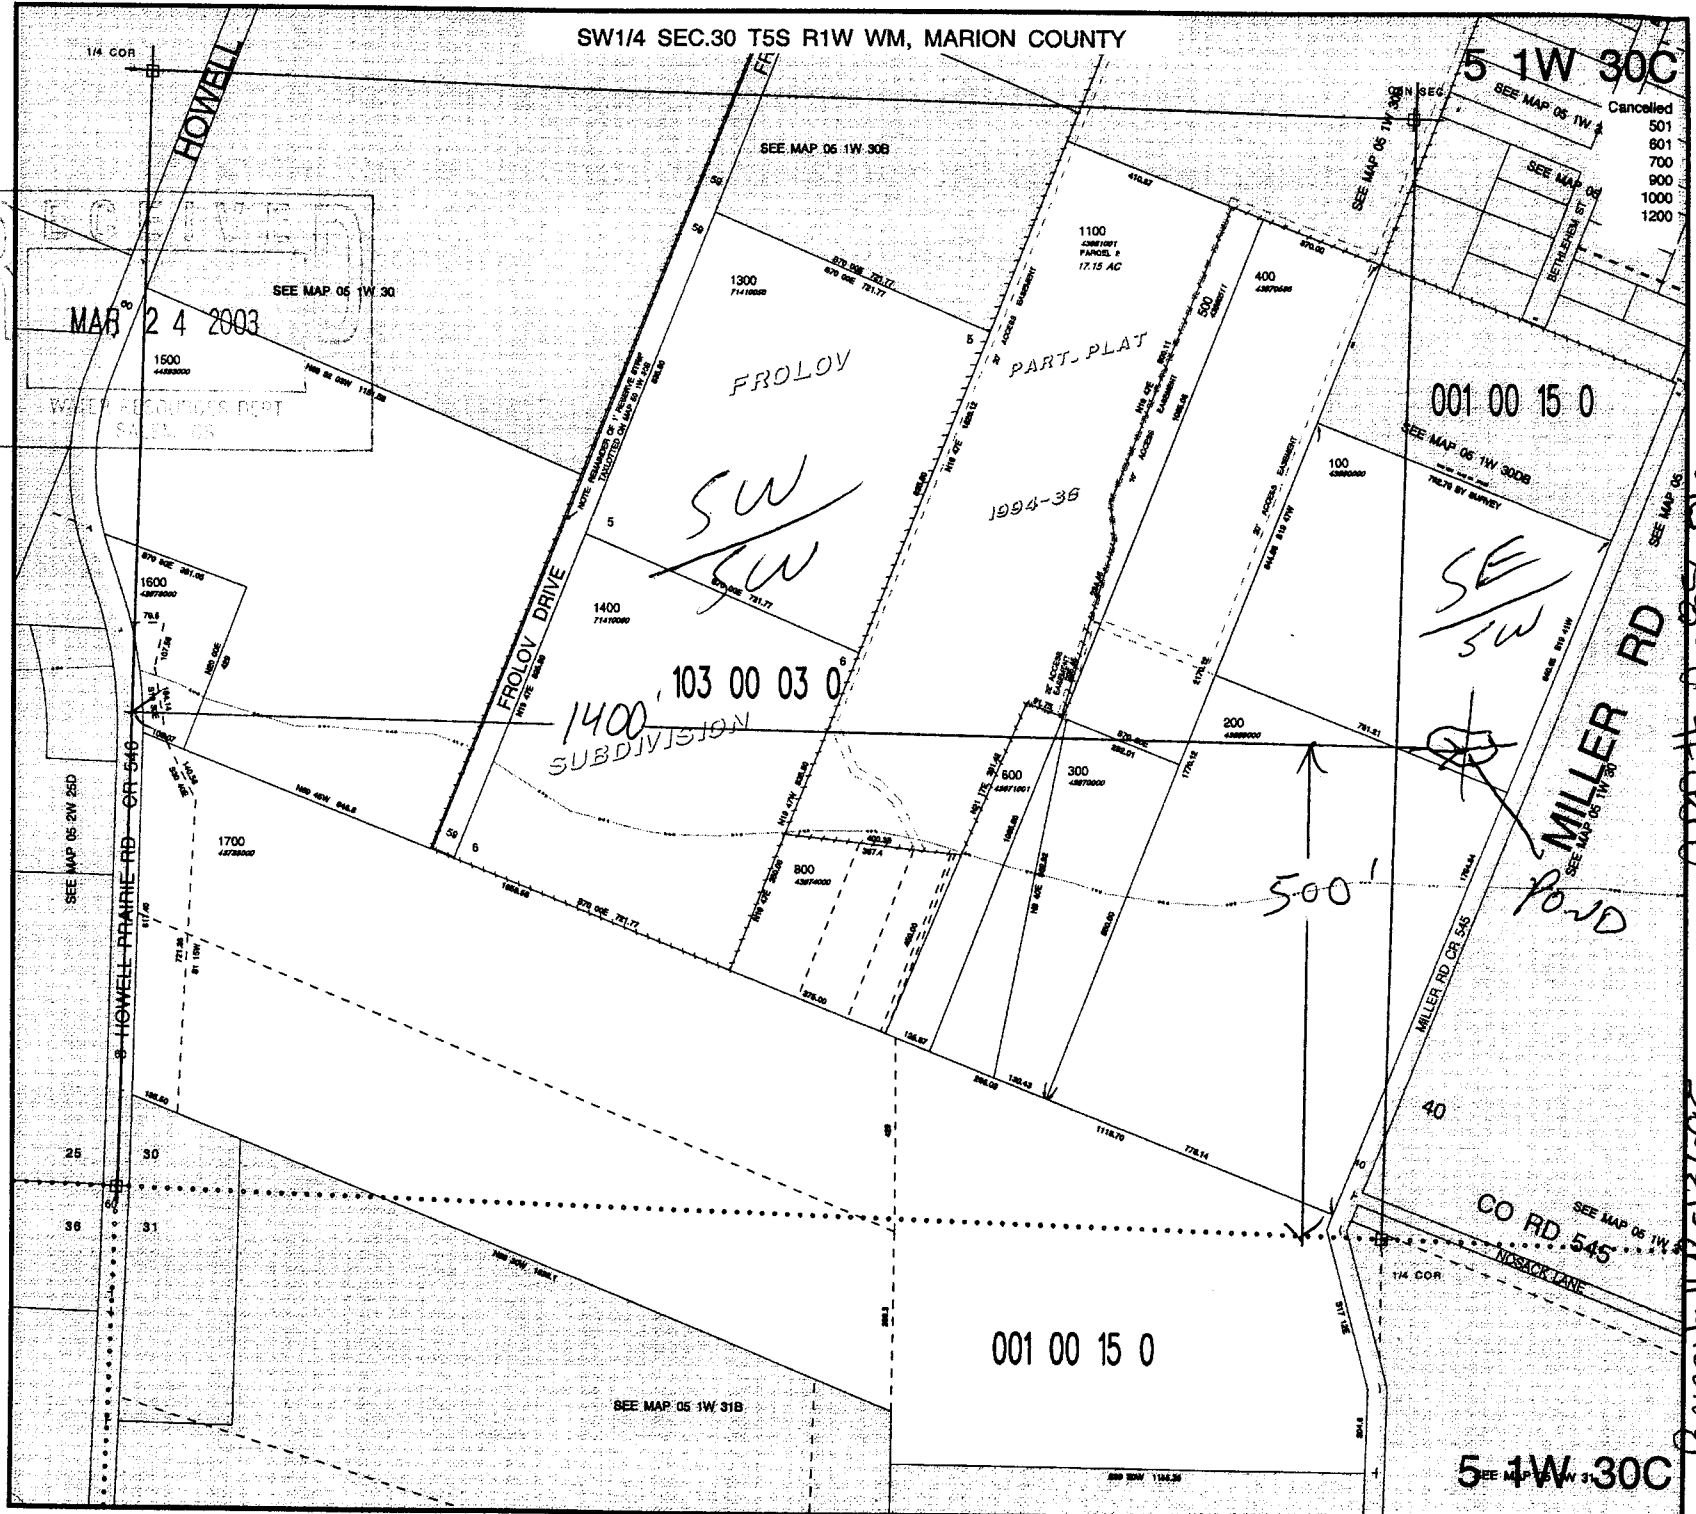

APP # R-85710
BANKIT # R-13695

5 1W 30C
Cancelled
501
601
700
800
900
1000
1200

001 00 15 0

SE SW

MILLER RD
500' POND

CO RD. 545

001 00 15 0

5 1W 30C