


CANCELLED TAX LOTS
100,200

Application No. R-84210 & R-84211
Permit No. R-12846 & R-12847

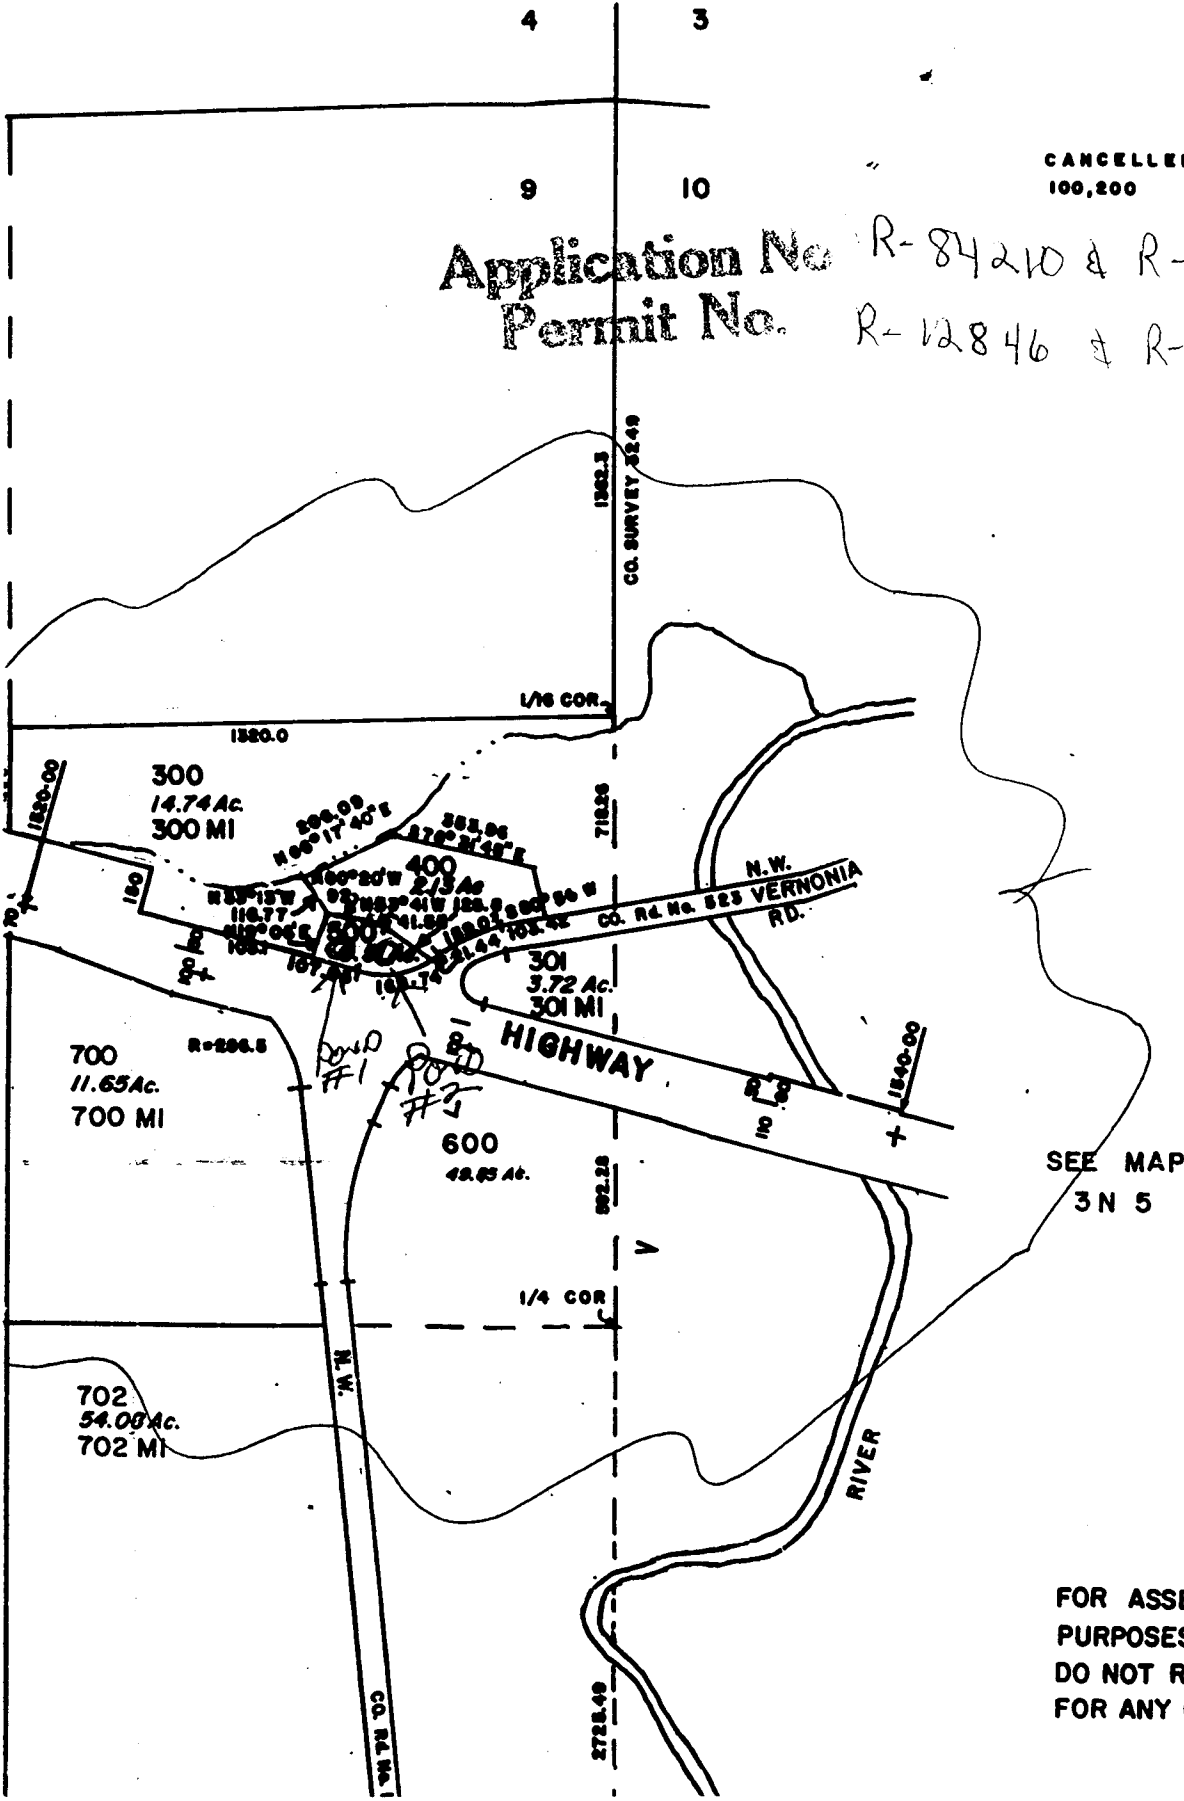

SEE MAP
3 N 5

FOR ASSESSMENT
PURPOSES ONLY
DO NOT RELY ON
FOR ANY OTHER USE