


Heffernan Water Storage Application

Tax Lot: 2200

Legal: NE 1/4, SE 1/4 Sec. 9 Twp. 6S R6E 38E

Coordinates: N 45° 03' 13"
W 118° 03' 21"

Name: Elk Flat Pond

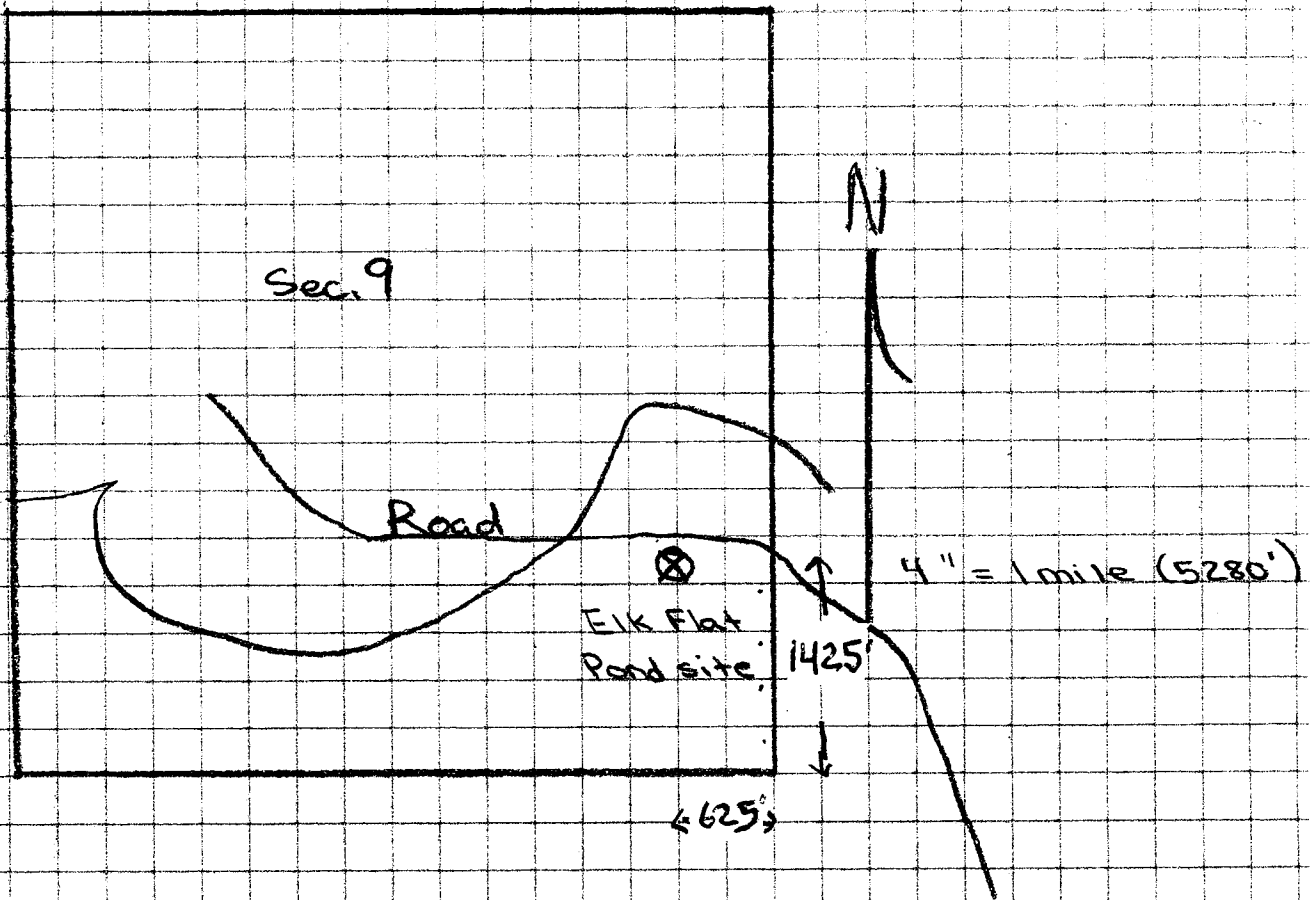

Pond Location: 1425' north
625' west
of the southeast section corner of Section 9

app # R-85582
Permit # R-13766

RECEIVED
MAY 01 2003
WATER RESOURCES DEPT.
SALEM, OREGON