


Heffernan Water Storage Application

Tax Lot: 2200

Legal: SW 1/4, SW 1/4, Sec. 15, Twp 6S, RGE 38E

Coordinates: N 45° 02' 16"
W 118° 03' 09"

Name: Stoves Pond

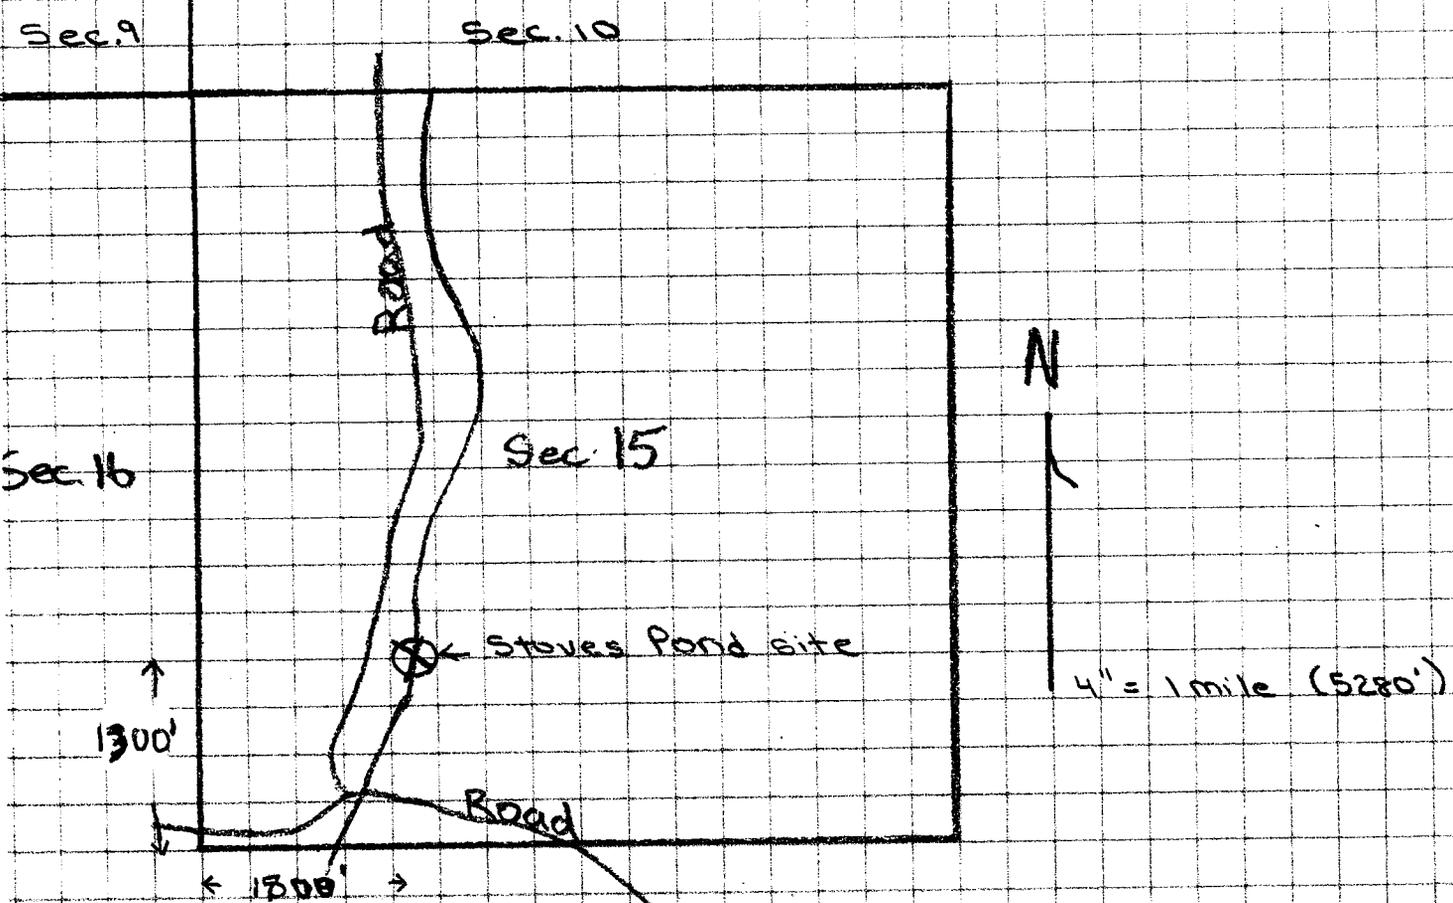

Pond Location: 1300' east
1300' north
of the southwest Section corner of Section 15

App # R-85583
Permit # R-13767

RECEIVED

MAY 01 2003

WATER RESOURCES DEPT
SALEM, OREGON